

STATE OF KANSAS
STATE CORPORATION COMMISSION
CONSERVATION DIVISION
P. O. BOX 17027
WICHITA, KANSAS 67217

FORM CP-4

WELL PLUGGING RECORD

Barton County, Sec. 21 Twp. 20 Rgs. 13 (E) (W)

Location as "NE/CNW/SW" or footage from lines NE NW SE

Lease Owner Nadel and Gussman

Lease Name PETROLEUM CLUB Well No. 1

Office Address 3232 First Natl Tower, Tulsa, Oklahoma 74103

Character of Well (completed as Oil, Gas or Dry Hole) Dry Hole

Date well completed January 17 19 76


Application for plugging filed January 17 19 76

Application for plugging approved January 17 19 76

Plugging commenced January 17 19 76

Plugging completed January 17 19 76

Reason for abandonment of well or producing formation Dry Hole

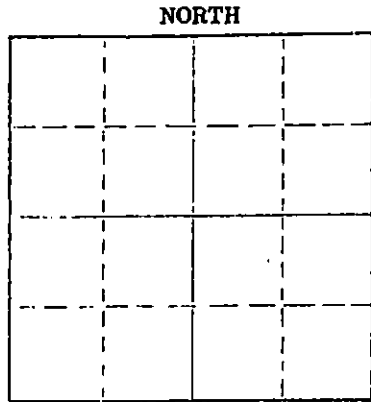

Locate well correctly on above Section Plot

If a producing well is abandoned, date of last production 19

Was permission obtained from the Conservation Division or its agents before plugging was commenced? yes

Name of Conservation Agent who supervised plugging of this well Duane Rankin

Producing formation Depth to top Bottom Total Depth of Well 3200 Feet

Show depth and thickness of all water, oil and gas formations.

OIL, GAS OR WATER RECORDS

CASING RECORD

Table with 7 columns: FORMATION, CONTENT, FROM, TO, SIZE, PUT IN, PULLED OUT. The table is currently empty.

Describe in detail the manner in which the well was plugged, indicating where the mud fluid was placed and the method or methods used in introducing it into the hole. If cement or other plugs were used, state the character of same and depth placed, from feet to feet for each plug set.

Hole full of heavy mud to 500' w/40 sacks cement thru drill pipe.
Mud to 300' w/25 sacks cement thru drill pipe.
Mud to 40' w/1/2 sack hulls plug & 10 sacks cement. 2 sacks cement in rat hole.

RECEIVED
STATE CORPORATION COMMISSION

Name of Plugging Contractor Duke Drilling Co. (If additional description is necessary, use BACK of this sheet)
Address Box 823, Great Bend, Ks. JAN 20 1976 1-20-76

STATE OF KANSAS COUNTY OF BARTON
Larry Curtis

(employee of owner) or (owner) of the above-described well, being first duly sworn on oath, says: That I have knowledge of the facts, statements, and matters herein contained and the log of the above-described well as filed and that the same are true and correct. So help me God

(Signature) Larry Curtis
Box 823, Great Bend, Ks. (Address)

SUBSCRIBED AND SWORN TO before me this 19th day of January 19 76

My commission expires April 11, 1978

Notary Public

Drillers' Well Log

Date Commenced: January 12, 1976

Date Completed: January 17, 1976

Nadel & Gussman
"Petroleum Club #1"
NE 1/4 SE
Section 21, T20S, R13W
Barton County, Kansas
Elevation: 1892 K.B.

- 0 - 106' Sand
- 106 - 195' Hard Sand, Shale, Sand
- 195 - 306' Shale & Sand
- 306 - 463' Shale & Red Bed
- 463 - 750' Red Bed
- 750 - 772' Anhydrite
- 772 - 1600' Shale & Shells
- 1600 - 3144' Shale & Lime
- 3144 - 3149' Shale
- 3149 - 3165' Shale & Lime
- 3165 - 3176' Lime
- 3176 - 3200' Shale

Formation Tops

Anhydrite	750
Heebner	3144
Toronto	3165
Douglas	3176
RJD	3200

Surface Pipe: Set 306' of
8-5/8" used 28", with 225 sacks
common, 2% Gel, 3% cc.

A 3 3 9 D A V 9 3

State of Kansas, County of Barton, ss.

Larry Curtis, of lawful age does swear and state that the facts and statements herein contained are true and correct to the best of his knowledge.

Larry Curtis

Subscribed and sworn to before me this 19 day of January 1976.

Deborah M. Sague
Notary Public

My Comm. Expires: April 11, 1978

RECEIVED
STATE CORPORATION COMMISSION

JAN 20 1976

CONSERVATION DIVISION
Wichita, Kansas