


STATE OF KANSAS
STATE CORPORATION COMMISSION

WELL PLUGGING RECORD

Give All Information Completely
Make Required Affidavit
Mail or Deliver Report to
Conservation Division
State Corporation Comm.
245 North Water
Wichita, KS 67202

Barton County, Sec. 21 Twp. 20 Rge. 13 ~~NE~~/W
Location as "NE/CNW $\frac{1}{4}$ SW $\frac{1}{4}$ " or footage from lines
1000' FSL & 50' FEL NW/4
Lease Owner Icer Addis
Lease Name ENGLEMAN Well No. 1
Office Address P.O. Drawer 8038, Wichita, Ks. 67208
Character of Well (Completed as Oil, Gas or Dry Hole)

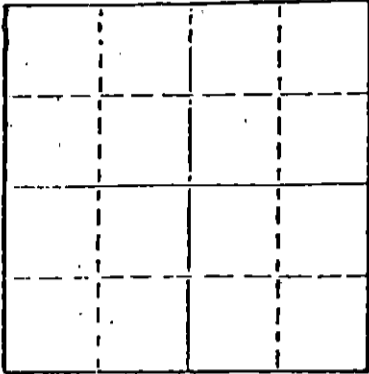

Locate well correctly on above
Section Plot

Dry Hole
Date Well completed 10-10 1979
Application for plugging filed 10-10 1979
Application for plugging approved 10-10 1979
Plugging commenced 10-10 1979
Plugging completed 10-10 1979
Reason for abandonment of well or producing formation

If a producing well is abandoned, date of last production 19

Was permission obtained from the Conservation Division or its agents before plugging was commenced? Yes

Name of Conservation Agent who supervised plugging of this well Duane Rankin
Producing formation Depth to top Bottom Total Depth of Well 3545'
Show depth and thickness of all water, oil and gas formations.

OIL, GAS OR WATER RECORDS

CASING RECORD

FORMATION	CONTENT	FROM	TO	SIZE	PUT IN	PULLED OUT

Describe in detail the manner in which the well was plugged, indicating where the mud fluid was placed and the method or methods used in introducing it into the hold. If cement or other plugs were used, state the character of same and depth placed, from feet to feet for each plug set.

- Bottom Plug @ 450' w/50 sacks cement thru Drill Pipe
- Middle Plug @ 300' w/25 sacks cement thru Drill Pipe
- Top Plug @ 40' w/ $\frac{1}{2}$ sack Hulls & 10 sacks cement
- 2 sacks cement in Rat Hole

RECEIVED
STATE CORPORATION COMMISSION

OCT 15 1979

CONSERVATION DIVISION
Wichita, Kansas

(If additional description is necessary, use BACK of this sheet)

Name of Plugging Contractor Duke Drilling Co., Inc.

STATE OF KANSAS COUNTY OF BARTON, ss.
Leonard Williamson (employee of owner) or ~~XXXXXXXXXXXXXXXXXXXX~~

of the above-described well, being first duly sworn on oath, says: That I have knowledge of the facts, statements, and matters herein contained and the log of the above-described well as filed and that the same are true and correct. So help me God.

(Signature) Leonard Williamson
(Address)

SUBSCRIBED AND SWORN TO before me this 11 day of October, 1979

Dorothy M. Tolague
Notary Public.

My commission expires April 11, 1982

DRILLERS' WELL LOG

DATE COMMENCED: October 3, 1979

DATE COMPLETED: October 10, 1979

Icer Adits
 HOLEMAN # 1
 1000' PSL & 50' PSL
 NW/4
 Sec. 21 - T20S - R39W
 Barton County, Ks.

0	-	123'	Sand
123	-	157'	Sand & Shale
157	-	329'	Hard Sand & Shale Streaks
329	-	375'	Shale, Red Bed
375	-	390'	Sand
390	-	420'	Red Bed
420	-	431'	Shale
431	-	749'	Red Bed
749	-	777'	Anhydrite
777	-	1713'	Red Bed
1713	-	2785'	Shale & Lime
2785	-	3134'	Lime
3134	-	3138'	Shale
3138	-	3153'	Lime & Shale
3153	-	3169'	Lime
3169	-	3252'	Shale
3252	-	3262'	Lime & Shale
3262	-	3481'	Lime
3481	-	3524'	Lime, Shale, Congl.
3524	-	3545'	Dolomite
		3545'	RFD

ELEVATION: 1883 K.B.

FORMATION DATA	
Anhydrite	749
Topoka	2785
Hochner	3134
Toronto	3153
Douglas	3169
Brown Lime	3252
Kansas City	3262
Base - K.O.	3481
Conglomerate	3502
Arbuckle	3524
RFD	3545

SURFACE PIPE: Set used
 5 5/8" pipe @ 339' w/250
 sacks 50/50 Pozmix, 2 1/2
 gal., 23% cc. (MISSION)

OCT 15 1979

CONSERVATION DIVISION
 Topeka, Kansas

AFFIDAVIT

State of Kansas
 County of Barton) ss.

Leonard Williamson, of lawful age does swear and state that the facts and statements herein contained are true and correct to the best of his knowledge.

Leonard Williamson

Subscribed and sworn to before me this 11 day of October, 1979

Dorothy M. Laque
 Notary Public