


Give All Information Completely  
Make Required Affidavit  
Mail or Deliver Report to:  
Conservation Division  
State Corporation Commission  
800 Bitting Building  
Wichita, Kansas

WELL PLUGGING RECORD

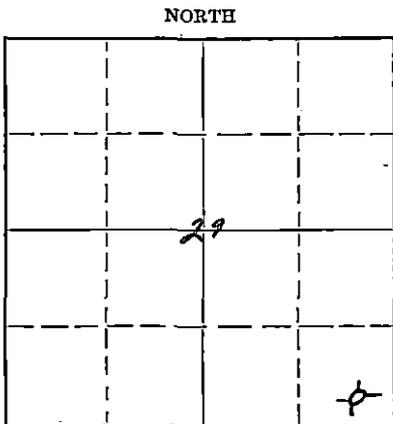

Locate well correctly on above Section Plat

Barton County, Sec. 29 Twp. 20 Rge. (E) 12(W)  
Location as "NE/CNW $\frac{1}{4}$ SW $\frac{1}{4}$ " or footage from lines SE SE SE  
Lease Owner Jay Bergman & Quaker Drilling Co., Inc.  
Lease Name McCullough Well No. 1  
Office Address Bitting Building, Wichita, Kansas  
Character of Well (completed as Oil, Gas or Dry Hole) Dry Hole  
Date well completed March 20 19 52  
Application for plugging filed March 20 19 52  
Application for plugging approved March 20 19 52  
Plugging commenced March 20 19 52  
Plugging completed March 20 19 52  
Reason for abandonment of well or producing formation Dry Hole

If a producing well is abandoned, date of last production..... 19.....  
Was permission obtained from the Conservation Division or its agents before plugging was commenced?..... yes

Name of Conservation Agent who supervised plugging of this well C. D. Stough  
Producing formation..... Depth to top..... Bottom..... Total Depth of Well 3516 Feet  
Show depth and thickness of all water, oil and gas formations.

OIL, GAS OR WATER RECORDS

CASING RECORD

Formation	Content	From	To	Size	Put In	Pulled Out
				8 5/8"	240'	cemented

Describe in detail the manner in which the well was plugged, indicating where the mud fluid was placed and the method or methods used in introducing it into the hole. If cement or other plugs were used, state the character of same and depth placed, from..... feet to..... feet for each plug set.

Heavy mud from 3516' to 240'. Set solid plug and 15 sacks cement through drill pipe. Mud to 40'. Set another plug and 10 sacks of cement.

3-25-52

SUN MAR 25 1952  
WICHITA, KANSAS

(If additional description is necessary, use BACK of this sheet)

Name of Plugging Contractor QUAKER DRILLING CO., INC.  
Address 1100 Bitting Building Wichita, Kansas

STATE OF Kansas, COUNTY OF Sedgwick, ss.  
Thomas M. McCaul (employee of owner) or (owner or operator) of the above-described well, being first duly sworn on oath, says: That I have knowledge of the facts, statements, and matters herein contained and the log of the above-described well as filed and that the same are true and correct. So help me God.

(Signature) Thomas M. McCaul

1100 Bitting Bldg. Wichita, Kansas  
(Address)

SUBSCRIBED AND SWORN to before me this 25th day of March, 19 52

Joe Ann Brown  
Notary Public.

My commission expires March 7, 1955

PLUGGING  
FILE SSC 29 1952  
BOOK PAGE 5 LINE 18

WELL LOG

Quaker Drilling Co., Inc. &  
Jay Bergman

Elevation: 1862 R.B.

Contractor: Quaker Drilling Co., Inc.

Commenced: 3-10-52

McCullough No. 1  
SE SE SE Sec. 29-20S-12W  
Barton County, Kansas

Completed: 3-20-52

Production: Dry & Abandoned

Casing Record:

Set 240' of 8 5/8" with 200 Sacks cement

(Figures indicate bottom of Formations)

<u>FORMATIONS</u>	<u>DEPTH</u>	<u>FORMATION TOPS</u>	
Surface Clay & Sand	190	Heebner	3088 -1226
Shale and Shells	240	Brown Lime	3215 -1353
Red Bed & Shale	660	Lansing	3228 -1366
Anhydrite	700	Conglomerate	3449 -1577
Shale and Shells	1630	Arbuckle	3485 -1623
Lime and Shale	1986	T. D. (r)	3516 -1654
Shale and Shells	2165		
Lime and Shale	2330		
Shale and Shells	2540		
Lime and Shale	3516 T.D.		

MAR 25 1952  
Wichita, Kansas

I hereby certify that the above is a true and correct copy of Driller's Log of Well drilled in the SE SE SE of Section 29, Township 20 South, Range 12 West, of Barton County, Kansas.

QUAKER DRILLING CO., INC.

By: J. Louis M. McCull

Subscribed and sworn to before me this 25 day of March, 1952.

J. Louis M. McCull  
Notary Public

My Commission Expires:  
March 7th, 1955

