


WELL PLUGGING RECORD

Give All Information Completely  
Make Required Affidavit  
Mail or Deliver Report to:  
Conservation Division  
State Corporation Commission  
211 So. Broadway  
Wichita, Kansas

Barton County. Sec. 29 Twp. 20S Rge.      (E) 12 (W)  
Location as "NE/CNW%SW%" or footage from lines Ctr. SE NE NE  
Lease Owner Monsanto Chemical Company (Lion Oil Company Division)  
Lease Name Sadie Well No. 1  
Office Address P. O. Box 580 Pratt, Kansas  
Character of Well (completed as Oil, Gas or Dry Hole) Dry Hole  
Date well completed November 21, 19 56  
Application for plugging filed November 21, 19 56  
Application for plugging approved Verbal November 21, 19 56  
Plugging commenced November 21, 19 56  
Plugging completed November 22, 19 56  
Reason for abandonment of well or producing formation Dry Hole

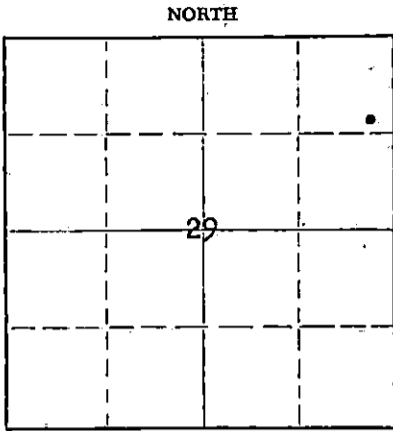

Locate well correctly on above Section Plat

If a producing well is abandoned, date of last production 19  
Was permission obtained from the Conservation Division or its agents before plugging was commenced? Yes

Name of Conservation Agent who supervised plugging of this well Mr. R. M. Brundage  
Producing formation none Depth to top      Bottom      Total Depth of Well 3510 Feet  
Show depth and thickness of all water, oil and gas formations.

OIL, GAS OR WATER RECORDS

CASING RECORD

| FORMATION | CONTENT | FROM | TO | SIZE   | PUT IN | PULLED OUT |
|-----------|---------|------|----|--------|--------|------------|
| none      |         |      |    | 8-5/8" | 275'   | None       |
|           |         |      |    |        |        |            |
|           |         |      |    |        |        |            |
Describe in detail the manner in which the well was plugged, indicating where the mud fluid was placed and the method or methods used in introducing it into the hole. If cement or other plugs were used, state the character of same and depth placed, from      feet to      feet for each plug set.  
Filled hole with heavy mud from 3510 to 240'. 1/3 sack hulls, Halliburton plug and 20 sacks cement. Heavy mud to 40'. 1/3 sack hulls, Halliburton plug and 10 sacks cement to base of cellar.

RECEIVED  
STATE CORPORATION COMMISSION

NOV 24 1956 11-24-56

CONSERVATION DIVISION  
Wichita, Kansas

(If additional description is necessary, use BACK of this sheet)  
Name of Plugging Contractor Garvey Drilling Company  
Address 311 East Third Wichita, Kansas

STATE OF Kansas, COUNTY OF Pratt, ss.  
I, J. B. Gibbs (employee of owner) or (owner or operator) of the above-described well, being first duly sworn on oath, says: That I have knowledge of the facts, statements, and matters herein contained and the log of the above-described well as filed and that the same are true and correct. So help me God.


(Signature) [Signature] District Production Superintendent  
P. O. Box 580 Pratt, Kansas  
(Address)

SUBSCRIBED AND SWORN TO before me this 23 rd. day of November, 19 56

My commission expires September 19, 1959

[Signature]  
Notary Public.

PLUGGING  
FILE SEC. 29 T. 20 R. 12W  
BOOK PAGE 118 LINE 44

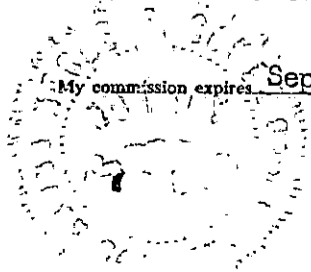

# WELL LOG

15:009.05628.0000

COMPANY LION OIL COMPANY

SEC. 29 T. 20S R. 12W

FARM SADIE

NO. 1

LOC. SE, NE, NE

TOTAL DEPTH 3510'

COUNTY Barton Co., Kansas

COMM. November 12, 1956

COMP. November 22, 1956

CONTRACTOR GARVEY DRILLING COMPANY



CASING 8 5/8" @ 273' W/225 sax.

ELEVATION 1856' DF

PRODUCTION D & A

FIGURES INDICATE BOTTOM OF FORMATIONS

|      |                     |              |      |
|------|---------------------|--------------|------|
| 235  | Sand                | Anhydrite    | 645  |
| 273  | Blue shale          | Heebner      | 3058 |
| 645  | Red bed             | Toronto      | 3078 |
| 670  | Anhydrite           | B. Lime      | 3183 |
| 1470 | Shale & shells      | Lansing      | 3202 |
| 1550 | Lime                | Cherty Cong. | 3438 |
| 2795 | Lime & shale        | Shaly Arb.   | 3453 |
| 3074 | Lime                |              |      |
| 3223 | Lime & shale        |              |      |
| 3440 | Lime                |              |      |
| 3465 | Lime & conglomerate |              |      |
| 3510 | Lime                |              |      |
| 3510 | T. D.               |              |      |

RECEIVED  
STATE CORPORATION COMMISSION  
CONSERVATION DIVISION  
WATER CONTROL

PLUGGING  
FILE SEC 29 T. 20 R. 12W  
BOOK PAGE 118 LI E. 44

State of KANSAS }  
County of BARTON } ss:

I, Verne A. Morris of Garvey Drilling Co.

upon oath state that the above and foregoing is a true and correct copy of the log of the #1 Sadie well

Verne A. Morris

Subscribed and sworn to before me this 27th day of November 19 56

My Commission Expires: November 12, 1958

Brumfitt  
NOTARY PUBLIC