


15.009.04965.0000

STATE OF KANSAS
STATE CORPORATION COMMISSION

Form CP-4

Give All Information Completely
Make Required Affidavit
Mail or Deliver Report to:
Conservation Division
State Corporation Commission
P. O. Box 17027
Wichita, Kansas 67217
NORTH

WELL PLUGGING RECORD

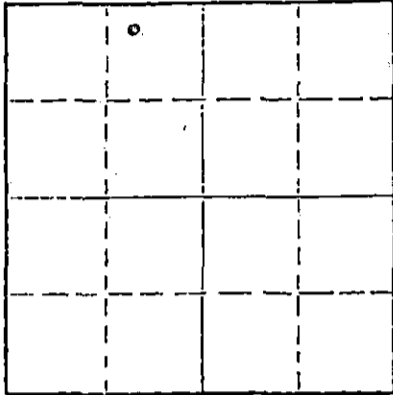

Locate well correctly on above
Section Plat

Barton County. Sec. 29 Twp. 20 Rgc. (E) 12 (W)
Location as "NE/CNW&SW" or footage from lines NW NE NW
Lease Owner Edmiston Oil Company
Lease Name Komark Well No. 2
Office Address 801 First National Bank Bldg., Wichita, Kansas
Character of Well (completed as Oil, Gas or Dry Hole) oil
Date well completed _____ 19____
Application for plugging filed _____ 19____
Application for plugging approved _____ 19____
Plugging commenced January 24 19 72
Plugging completed January 29 19 72
Reason for abandonment of well or producing formation depleted

If a producing well is abandoned, date of last production _____ 19____
Was permission obtained from the Conservation Division or its agents before plugging was commenced? YES

Name of Conservation Agent who supervised plugging of this well Donald Truan
Producing formation _____ Depth to top _____ Bottom _____ Total Depth of Well 3491 Feet
Show depth and thickness of all water, oil and gas formations.

OIL, GAS OR WATER RECORDS

CASING RECORD

FORMATION	CONTENT	FROM	TO	SIZE	PUT IN	PULLED OUT
		0	261'	8 5/8"	261'	none
		0	3490'	4 1/2"	3490'	2025.60

Describe in detail the manner in which the well was plugged, indicating where the mud fluid was placed and the method or methods used in introducing it into the hole. If cement or other plugs were used, state the character of same and depth placed, from _____ feet to _____ feet for each plug set.

Sanded back to 3230' and dumped 4 sacks of cement.

Plugged well pumping in 20 sacks of gel, 1 sack of hulls and 100 sacks of cement.

RECEIVED
STATE CORPORATION COMMISSION
FEB 2 1972
CONSERVATION DIVISION
Wichita, Kansas

Name of Plugging Contractor PIPE PULLERS, INC.
Address Box 486, Ellinwood, Kansas 67526

STATE OF KANSAS COUNTY OF BARTON, SS.
Evelyn Roth

(employee of owner) or (owner or operator) of the above-described well, being first duly sworn on oath, says: That I have knowledge of the facts, statements, and matters herein contained and the log of the above-described well as filed and that the same are true and correct. So help me God.

(Signature) Evelyn Roth
Ellinwood, Kansas
(Address)

SUBSCRIBED AND SWORN TO before me this 1st day of February, 19 72

My commission expires Feb. 10, 1975

Seagull Meyer
Notary Public.

COMPANY: E. K. Edmiston
 802 Union National Bldg.
 Wichita 2, Kansas

ROTARY DRILLING COMMENCED: July 24, 1961

ROTARY DRILLING COMPLETED: August 3, 1961

Well Name: Komarek #2
 NW NE NW Sec. 29-20-12W
 Barton County, Kansas

Contractor: E. K. Edmiston Drilling Co., Inc.
 802 Union National Bldg.
 Wichita, Kansas

Casing record: 8 5/8" @ 262 w/250 sacks
 4 1/2" @ 3490 w/55 sacks

LOG

Measurements from top of Rotary Bushing:

Sand	0	200
Sand & shale		262
Red Bed & Shale		650
Anhydrite		675
Shale		1450
Shale & Lime		1590
Lime		1855
Lime & Shale		1960
Shale & lime		2616
Lime & shale		2955
Lime		3011
Lime & shale		3206
Lime		3490 Rotary Total Depth

RECEIVED
 STATE CORPORATION COMMISSION
 JAN 24 1972
 CONSERVATION DIVISION
 Wichita, Kansas

The undersigned, E. K. Edmiston, President of the E. K. Edmiston Drilling Company, Inc., hereby certifies, in behalf of said company that the above log is a true and correct log of the formations encountered in drilling the above well as reflected by the Daily Drilling Reports.

E. K. EDMISTON DRILLING CO., INC.

By [Signature]
E. K. Edmiston President

STATE OF KANSAS)
) ss
COUNTY OF SEDGWICK)

BE IT REMEMBERED that, on this 17th day of August, 1961, before me, the undersigned, a Notary Public duly commissioned in and for the State and County aforesaid, came E. K. Edmiston, known to me to be the same person who executed the foregoing instrument as President and in behalf of the E. K. Edmiston Drilling Company, Inc. and he duly acknowledged the execution of the same for himself and for said company.

IN WITNESS WHEREOF, I have hereunto set my hand and official seal on the day and year last above written.

Frances Marler
Frances Marler Notary Public

My commission expires: August 25, 1964

