


Give All Information Completely
Make Required Affidavit
Mail or Deliver Report to:
Conservation Division
State Corporation Commission
211 No. Broadway
Wichita, Kansas

WELL PLUGGING RECORD

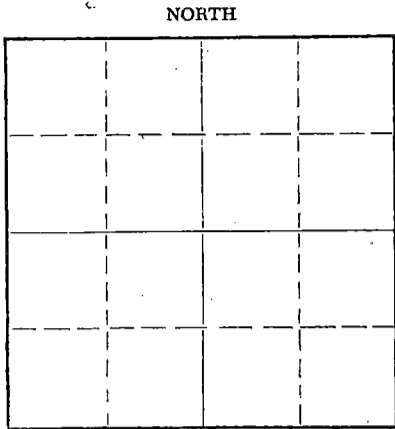

Locate well correctly on above Section Plat

Barton County. Sec. 35 Twp. 20S Rge. (E) 11 (W)
Location as "NE/CNW/SW" or footage from lines NW NE SE
Lease Owner Chief Drilling Co., Inc.
Lease Name DOLL Well No. 1
Office Address Box 797, Great Bend, Kansas
Character of Well (completed as Oil, Gas or Dry Hole) Dry Hole
Date well completed June 11 19 61
Application for plugging filed June 10 19 61
Application for plugging approved June 11 19 61
Plugging commenced June 11 19 61
Plugging completed June 11 19 61
Reason for abandonment of well or producing formation

If a producing well is abandoned, date of last production 19
Was permission obtained from the Conservation Division or its agents before plugging was commenced? yes

Name of Conservation Agent who supervised plugging of this well Don Truan, Russell
Producing formation Depth to top Bottom Total Depth of Well 3377 Feet
Show depth and thickness of all water, oil and gas formations.

OIL, GAS OR WATER RECORDS

CASING RECORD

FORMATION	CONTENT	FROM	TO	SIZE	PUT IN	PULLED OUT
				8 5/8"	230'	None

Describe in detail the manner in which the well was plugged, indicating where the mud fluid was placed and the method or methods used in introducing it into the hole. If cement or other plugs were used, state the character of same and depth placed, from feet to feet for each plug set.

1/3 sx hulls and wooden plug set @ 230'
Mixed 25 sx cement thru drill pipe
1/2 sx hulls and wooden plug set @ 30'
Mixed 10 sx cement
Plug and 2 sx cement in rat hole.

RECEIVED
STATE CORPORATION COMMISSION
JUN 15 1961
CONSERVATION DIVISION
Wichita, Kansas

(If additional description is necessary, use BACK of this sheet)
Name of Plugging Contractor Chief Drilling Co., Inc.
Address P.O. Box 797, Great Bend, Kansas

STATE OF KANSAS, COUNTY OF BARTON, ss.
V. Richard Hoover, President (employee of owner) or (owner or operator) of the above-described well, being first duly sworn on oath, says: That I have knowledge of the facts, statements, and matters herein contained and the log of the above-described well as filed and that the same are true and correct. So help me God.
(Signature) V. Richard Hoover
V. Richard Hoover - President
P.O. Box 797, Great Bend, Kansas
(Address)

SUBSCRIBED AND SWORN TO before me this 14th day of June, 19 61

Dorothy B. John
Dorothy B. John
Notary Public.

My commission expires June 18, 1963



WELL LOG

Chief Drilling Co., Inc.
P. O. Box 737
Great Bend, Kansas

No. 1 Well
NW 1/4 Sec. 35-205-111
Barton County, Kansas

Contractor: Chief Drilling Co., Inc.

Commenced: 6-2-61
Completed: 6-11-61

CASING RECORD: 3 5/8" @ 235' cemented with 200 sacks Sunset cement.

FORMATION	FEET	TO	ELEVATION
Sand	0	120	
Red Bed and Shale	150	235	1766' Gr.
Shale and Sand	235	498	1763' D.P.
Anhydrite	498	515	1771' H.S.
Shale & Shells	515	1475	
Line	1475	1615	
Line & Shale	1615	2650	
Line	2650	2903	
Shale & Line	2903	3052	Anhydrite 468'
Line	3052	3261	Restone 2903'
Shale & Line	3261	3301	Brown Line 3029'
Conglomerate	3301	3332	Massing 3052'
Dolomite	3332	3377	Conglomerate 3301'
Total Depth	3377		Articula 3332'

STATE OF KANSAS, COUNTY OF BARTON) SS

I hereby certify that the above is a true and correct copy of the Driller's Log of the well drilled in the NW 1/4 Sec. 35-205-111, Barton County, Kansas, to the best of my knowledge and belief.

CHIEF DRILLING CO., INC.
V. Richard Hoover
V. Richard Hoover, President

Subscribed and sworn to before me this 14th day of June, 1961

Dorothy B. John
Dorothy B. John, Notary Public

My commission expires: June 18, 1963

RECEIVED
STATE CORPORATION COMMISSION
JUN 15 1961
CONSERVATION DIVISION
Wichita, Kansas