

R


STATE OF KANSAS
STATE CORPORATION COMMISSION

Give All Information Completely
Make Required Affidavit
Mail or Deliver Report to:
Conservation Division
State Corporation Commission
212 No. Market
Wichita, Kansas

WELL PLUGGING RECORD

PAWNEE County. Sec. 5 Twp. 20 Rge. 20 (E) W (W)

Location as "NE/CNWxSWx" or footage from lines C NE NE
Lease Owner C-G DRILLING CO & GEORGE REED
Lease Name ISAAC #3 Well No.
Office Address 1107 UNION NATIONAL BLDG.
Character of Well (completed as Oil, Gas or Dry Hole) DRY HOLE
Date well completed OCT. 9, 1969 19
Application for plugging filed OCT. 9, 1969 19
Application for plugging approved OCT. 9, 1969 19
Plugging commenced OCT. 9, 1969 19
Plugging completed OCT. 9, 1969 19
Reason for abandonment of well or producing formation TOO LOW STRUCTURALLY

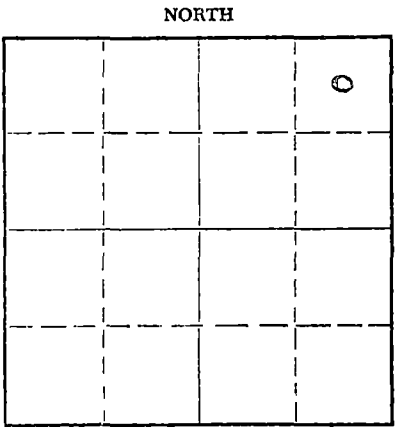

Locate well correctly on above Section Plat

If a producing well is abandoned, date of last production 19
Was permission obtained from the Conservation Division or its agents before plugging was commenced? YES

Name of Conservation Agent who supervised plugging of this well LEO F MASSEY, HAYS, KANSAS
Producing formation Depth to top Bottom Total Depth of Well 4365' Feet
Show depth and thickness of all water, oil and gas formations.

OIL, GAS OR WATER RECORDS

CASING RECORD

FORMATION	CONTENT	FROM	TO	SIZE	PUT IN	PULLED OUT
				8-5/8"	278.68'	NONE

Describe in detail the manner in which the well was plugged, indicating where the mud fluid was placed and the method or methods used in introducing it into the hole. If cement or other plugs were used, state the character of same and depth placed, from feet to feet for each plug set:

FILLED WITH HEAVY MUD TO 600'. SET PLUG.
PUT IN 70 SACKS CEMENT. FILLED WITH HEAVY
MUD TO 270'. SET PLUG. PUT IN 20 SX CEMENT.
FILLED WITH HEAVY MUD TO 40'. SET PLUG.
PUT IN 10 SACKS AND 1 SACK HULLS.

RECEIVED
STATE CORPORATION COMMISSION
OCT 23 1969
CONSERVATION DIVISION
Wichita, Kansas


(If additional description is necessary, use BACK of this sheet)
Name of Plugging Contractor C-G DRILLING CO.
Address 1107 UNION NATIONAL BLDG., WICHITA, KANSAS 67202

STATE OF KANSAS COUNTY OF SEDGWICK, ss.
JAY H GALLOWAY (employee of owner) or (owner or operator) of the above-described well, being first duly sworn on oath, says: That I have knowledge of the facts, statements, and matters herein contained and the log of the above-described well as filed and that the same are true and correct. So help me God.

(Signature) JAY H GALLOWAY 1107 UNION NATL. BLDG.
(Address)

Subscribed and Sworn to before me this 17th day of OCTOBER, 19 69
My commission expires 7, 1969

Phyllis Buchanan
PHYLLIS BUCHANAN Notary Public.

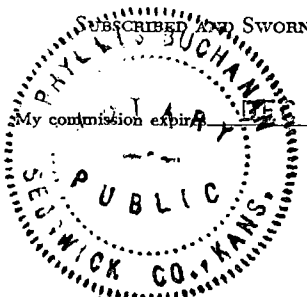

69

WELL LOG

OPERATOR: C-G DRILLING & GEO REED

WELL NAME: ISAAC #3 LOCATION: C NE NE SEC 5-20-20W

COUNTY: PAWNEE COUNTY STATE: KANSAS

WELL COMMENCED: SEPT 30, 1969 WELL COMPLETED: OCT 9, 1969

ELEVATION: 2210 KB TOTAL DEPTH: 4365'

PRODUCTION: DRY & ABANDONED RIG NO: 1

CASING - 8-5/8": 8 jts 278.68 W/150 SX CEMENT

5-1/2":

ALL MEASUREMENTS TAKEN FROM THE TOP OF ROTARY BUSHING:

FROM	TO	FORMATION	DEVIATION FROM VERTICAL	REMARKS:
0	825	SHALE	1° 550'	DST #1 4331-4340
825	1040	SAND	1/2° 1100'	DST #2 4342-4351
1040	1350	RED BED	1° 1905'	DST #3 4352-4365
1350	1404	RED BED & SHALE		
1404	1444	ANHYDRITE		
1444	2070	SHALE		
2070	3815	LIME & SHALE		
3815	4225	LIME		
4225	4300	LIME & SHALE		
4300	4340	LIME		

RECEIVED
 STATE CORPORATION COMMISSION
 OCT 23 1969
 CONSERVATION DIVISION
 Wichita, Kansas

STATE OF KANSAS)
 COUNTY OF SEDGWICK) SS:

The undersigned hereby certifies that to the best of his knowledge and belief, the above facts are true and correct.

C-G DRILLING CO.

By Jay H Galloway
 JAY H GALLOWAY

SUBSCRIBED AND SWORN TO, BEFORE ME, This 17th day of OCT., 1969.

MY COMM. EXP. DEC. 7, 1971

Phyllis Buchanan
 PHYLLIS BUCHANAN - NOTARY PUBLIC

