

STATE OF KANSAS  
STATE CORPORATION COMMISSION

Give All Information Completely  
Make Required Affidavit  
Mail or Deliver Report to:  
Conservation Division  
State Corporation Commission  
212 No. Market  
Wichita, Kansas

WELL PLUGGING RECORD

PAWNEE County, Sec. 5 Twp. 20 Rge. 20 (E) (W)

Location as "NE/CNWxSWx" or footage from lines C NE NW

Lease Owner GEORGE A REED

Lease Name IKE Well No. 1

Office Address 1223 UNION NATL BLDG, WICHITA, KANSAS 67202

Character of Well (completed as Oil, Gas or Dry Hole) DRY HOLE

Date well completed SEPT 12 1970

Application for plugging filed SEPT 12 1970

Application for plugging approved SEPT 12 1970


Plugging commenced SEPT 12 1970

Plugging completed SEPT 12 1970

Reason for abandonment of well or producing formation TOO LOW STRUCTURALLY

If a producing well is abandoned, date of last production 19

Was permission obtained from the Conservation Division or its agents before plugging was commenced? YES

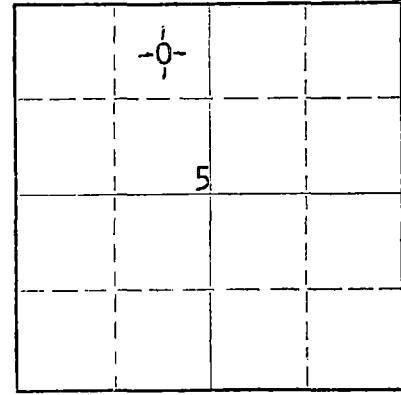

Locate well correctly on above Section Plat

Name of Conservation Agent who supervised plugging of this well DONALD TRUAN, RUSSELL KANSAS

Producing formation Depth to top Bottom Total Depth of Well 4404 Feet

Show depth and thickness of all water, oil and gas formations.

OIL, GAS OR WATER RECORDS

CASING RECORD

FORMATION	CONTENT	FROM	TO	SIZE	PUT IN	PULLED OUT
				8 5/8"	278.97	NONE
RECEIVED STATE CORPORATION COMMISSION OCT 7 1970 CONSERVATION DIVISION						

Describe in detail the manner in which the well was plugged, indicating where the mud fluid was placed, the method or methods used in introducing it into the hole. If cement or other plugs were used, state the character of same and depth placed, from feet to feet for each plug set.

FILLED WITH HEAVY MUD TO 600'. SET PLUG.  
PUT IN 70 SACKS CEMENT. FILLED WITH HEAVY  
MUD TO 250'. SET PLUG. PUT IN 20 SACKS  
CEMENT. FILLED WITH HEAVY MUD TO 40'.  
SET PLUG. FILLED TO TOP WITH 1/2 SACKS  
HULLS & 10 SACKS CEMENT.

(If additional description is necessary, use BACK of this sheet)

Name of Plugging Contractor C-G DRILLING CO

Address 1107 UNION NATIONAL BLDG, WICHITA, KANSAS 67202

STATE OF KANSAS, COUNTY OF SEDGWICK, ss.


Jay H. Galloway (employee of owner) or (owner or operator) of the above-described well, being first duly sworn on oath, says: That I have knowledge of the facts, statements, and matters herein contained and the log of the above-described well as filed and that the same are true and correct. So help me God.

(Signature) Jay H. Galloway 1107 Union National Bldg.  
(Address)

Subscribed and sworn to before me this 12th day of September, 1970

My commission expires NOT December 7, 1971

Phyllis Buchanan Notary Public.

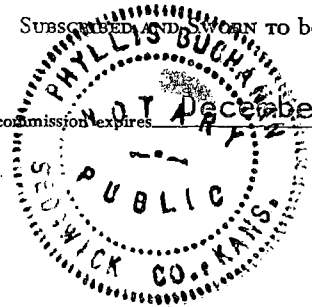

W E L L L O G

RECEIVED  
STATE CORPORATION COMMISSION

OCT 7 1970

OPERATOR: GEORGE A REED

CONSERVATION DIVISION

WELL NAME: IKE #1

LOCATION: C NE NW Wichita, Kansas

COUNTY: PAWNEE

STATE: KANSAS

WELL COMMENCED: SEPT 9, 1970

WELL COMPLETED: SEPT 12, 1970

ELEVATION: 2241 KB

TOTAL DEPTH: 4404

PRODUCTION: DRY & ABANDONED

RIG NO: 1

CASING - 8-5/8": NEW 20# @ 278.97' W/150 SX QUICKSET

5-1/2":                     

ALL MEASUREMENTS TAKEN FROM THE TOP OF ROTARY BUSHING:

FROM	TO	FORMATION	DEVIATION FROM VERTICAL	REMARKS:
0	570	SAND AND SHALE	1° 520'	
570	840	SHALE	1/4° 1100'	
840	1065	SAND		
1065	1435	RED BED		
1435	1465	ANHYDRITE		
1465	2140	SHALE & SHELLS	1° 2275	
2140	3730	LIME & SHALE		
3730	4140	LIME		
4140	4255	LIME & SHALE		
4255	4315	LIME		
4315	4360	LIME & SHALE		
4360	4377	CHERT & LIME		
4377	4404	LIME		

DST #1 4373-4382

STATE OF KANSAS )  
COUNTY OF SEDGWICK) SS:

The undersigned hereby certifies that to the best of his knowledge and belief, the above facts are true and correct.

C-G DRILLING CO.

By Jay H Galloway

JAY H GALLOWAY

SUBSCRIBED AND SWORN TO, BEFORE ME, This 11th day of September, 1970.

MY COMM. EXP. DEC. 7, 1971

Phyllis Buchanan  
PHYLLIS BUCHANAN - NOTARY PUBLIC

