

STATE OF KANSAS
STATE CORPORATION COMMISSION

Give All Information Completely
Make Required Affidavit
Mail or Deliver Report to:
Conservation Division
State Corporation Commission
212 No. Market
Wichita, Kansas

WELL PLUGGING RECORD

PAWNEE

County. Sec. 5 Twp. 20S Rge. 20 (E) W (W)

Location as "NE/CNW%SW%" or footage from lines C SE NW

Lease Owner C-G DRILLING CO. - G A REED

Lease Name MILLER #2 Well No.

Office Address 1107 UNION NATIONAL BLDG.

Character of Well (completed as Oil, Gas or Dry Hole) DRY HOLE

Date well completed JANUARY 7, 1969 19

Application for plugging filed JANUARY 7, 1969 19

Application for plugging approved JANUARY 7, 1969 19


Plugging commenced JANUARY 7, 1969 19

Plugging completed JANUARY 7, 1969 19

Reason for abandonment of well or producing formation TOO LOW STRUCTURALLY

If a producing well is abandoned, date of last production 19

Was permission obtained from the Conservation Division or its agents before plugging was commenced? YES

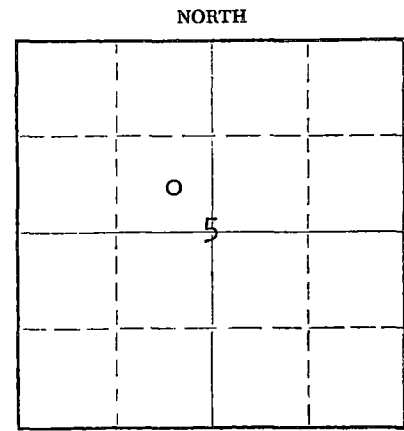

Locate well correctly on above Section Plat

Name of Conservation Agent who supervised plugging of this well LEO F MASSEY

Producing formation Depth to top Bottom Total Depth of Well 4390 Feet

Show depth and thickness of all water, oil and gas formations.

OIL, GAS OR WATER RECORDS

CASING RECORD

FORMATION	CONTENT	FROM	TO	SIZE	PUT IN	PULLED OUT
				8-5/8"	277.72'	NONE

Describe in detail the manner in which the well was plugged, indicating where the mud fluid was placed and the method or methods used in introducing it into the hole. If cement or other plugs were used, state the character of same and depth placed, from feet to feet for each plug set.

FILLED WITH HEAVY MUD TO 600'. SET PLUG. PUT IN 70 SACKS CEMENT. FILLED WITH HEAVY MUD TO 270'. SET PLUG. PUT IN 20 SACKS CEMENT. FILLED WITH HEAVY MUD UP TO 40'. SET PLUG. FILLED TO TOP WITH 1/2 SACK HULLS AND 10 SACKS CEMENT.

RECEIVED
STATE CORPORATION COMMISSION
JAN 17 1969
CONSERVATION DIVISION
Wichita, Kansas

Name of Plugging Contractor C-G DRILLING CO. (If additional description is necessary, use BACK of this sheet)
Address 1107 UNION NATIONAL BUILDING, WICHITA, KANSAS 67202


STATE OF KANSAS, COUNTY OF SEDGWICK, ss.
G F GALLOWAY (employee of owner) or (owner or operator) of the above-described

well, being first duly sworn on oath, says: That I have knowledge of the facts, statements, and matters herein contained and the log of the above-described well as filed and that the same are true and correct. So help me God.

(Signature) G F GALLOWAY 1107 UNION NATIONAL BLDG. (Address)

SUBSCRIBED AND SWORN to before me this 13th day of JANUARY, 19 69

My commission expires 7, 1971
Phyllis Buchanan
PHYLLIS BUCHANAN Notary Public.

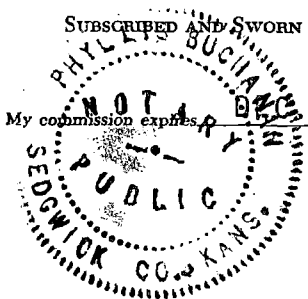

W E L L L O G

OPERATOR: C -G DRILLING CO. & G A REED
 WELL NAME: MILLER #2 LOCATION: C SE NW SEC 5-20S-20W
 COUNTY: PAWNEE STATE: KANSAS
 WELL COMMENCED: DEC. 30, 1968 WELL COMPLETED: JAN. 7, 1969
 ELEVATION: 2220 KB TOTAL DEPTH: 4390'
 PRODUCTION: DRY & ABANDONED RIG NO: 1
 CASING - 8-5/8": 8 jts 277.72' W/150 SACKS QUICKSET
 5-1/2": _____

ALL MEASUREMENTS TAKEN FROM THE TOP OF ROTARY BUSHING:

FROM	TO	FORMATION	DEVIATION FROM VERTICAL	REMARKS:
277	600	SHALE	1/2° 500'	DST #1 4292-4354
600	845	SHALE & RED BED	1-1/4° 1050'	
845	1050	SAND	3/4° 1600'	
1050	1415	RED BED	1/4° 2000'	
1415	1458	ANHYDRITE	1° 2600'	
1458	1725	SHALE & SHELL	3/4° 3000'	
1725	2230	SHALE	3/4° 3580'	
2230	2414	LIME & SHALE	1° 4040'	
2414	2545	LIME		
2545	3935	LIME & SHALE		
3935	4250	LIME		
4250	4290	LIME & SHALE		
4290	4365	LIME		
4365	4375	LIME & SHALE		
4375	4390	MISSISSIPPIAN		

RECEIVED
 STATE CORPORATION COMMISSION
 JAN 17 1969
 CONSERVATION DIVISION
 Wichita, Kansas

STATE OF KANSAS)
 COUNTY OF SEDGWICK) SS:

The undersigned hereby certifies that to the best of his knowledge and belief, the above facts are true and correct.

C-G DRILLING CO.

By [Signature]

AND SWORN TO, BEFORE ME, This 13th day of JANUARY, 1969.

EXPIRES DEC. 7, 1971

[Signature]
 PHYLLIS BUCHANAN - NOTARY PUBLIC

