


STATE OF KANSAS  
STATE CORPORATION COMMISSION

Form CP-4

Give All Information Completely  
Make Required Affidavit  
Mail or Deliver Report to:  
Conservation Division  
State Corporation Commission  
212 No. Market  
Wichita, Kansas

WELL PLUGGING RECORD

NORTH

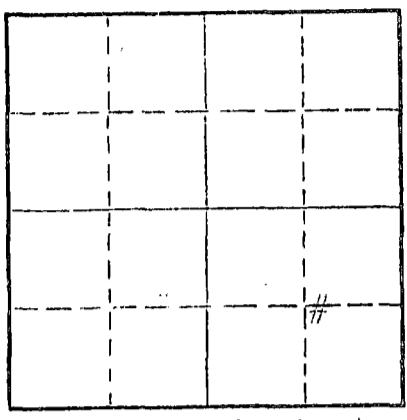

Locate well correctly on above Section Plat

Pawnee County. Sec. 21 Twp. 20 Rge. 19 (E) W (W)  
Location as "NE/CNW/SE/SW" or footage from lines SE SE NW  
Lease Owner Pickrell Drilling Co.  
Lease Name Balman "B" Well No. 1  
Office Address 705 Fourth Natl. Bank Bldg. Wichita, Ks.  
Character of Well (completed as Oil, Gas or Dry Hole) Dry hole  
Date well completed 1-31-68 Jan. 31, 1968  
Application for plugging filed Feb. 21, 1968  
Application for plugging approved Feb. 26, 1968  
Plugging commenced Feb. 22, 1968  
Plugging completed Feb. 24, 1968  
Reason for abandonment of well or producing formation \_\_\_\_\_

If a producing well is abandoned, date of last production \_\_\_\_\_ 19\_\_\_\_  
Was permission obtained from the Conservation Division or its agents before plugging was commenced? Yes

Name of Conservation Agent who supervised plugging of this well Leo Massey  
Producing formation \_\_\_\_\_ Depth to top \_\_\_\_\_ Bottom \_\_\_\_\_ Total Depth of Well 4272 Feet  
Show depth and thickness of all water, oil and gas formations. 4272

OIL, GAS OR WATER RECORDS

CASING RECORD

FORMATION	CONTENT	FROM	TO	SIZE	PUT IN	PULLED OUT
				8 5/8	435'	None
				5 1/2	4268'	3415'

Describe in detail the manner in which the well was plugged, indicating where the mud fluid was placed and the method or methods used in introducing it into the hole. If cement or other plugs were used, state the character of same and depth placed, from \_\_\_\_\_ feet to \_\_\_\_\_ feet for each plug set.

Plugged back with sand from 4282' to 4250'. Mixed and dumped 5 sx. of cement from 4250' to 4210'. Pulled casing. Mixed and pumped in 20 sx. of gel. Mixed and pumped in 120 sx. of cement plus 6% gel from 435' to base of the cellar.

RECEIVED  
STATE CORPORATION COMMISSION  
MAR 1 1 1968  
CONSERVATION DIVISION  
Wichita, Kansas

(If additional description is necessary, use BACK of this sheet)


Name of Plugging Contractor Russ Casing Pulling Inc.  
Address P.O. Box 1082 Great Bend, Ks.

STATE OF KANSAS COUNTY OF SEDGWICK, ss.  
C. W. Sebitts (owner or operator) of the above-described

well, being first duly sworn on oath, says: That I have knowledge of the facts, statements and matters herein contained and the log of the above-described well as filed and that the same are true and correct. So help me God.

(Signature) [Signature]  
C. W. Sebitts, Partner & Attorney-in-Fact  
705 4th Natl Bk Bldg., Wichita, Ks. 67202  
(Address)

SUBSCRIBED AND SWORN to before me this 6th day of March, 1968

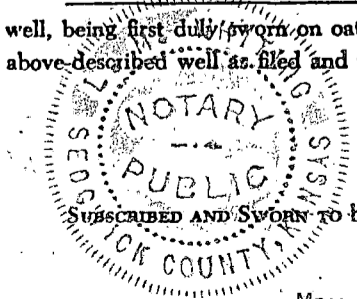

My commission expires May 10, 1970  
L. M. Whiting Notary Public.

ROTARY DRILLING LOG

COMPANY: Pickrell Drilling Company  
705 Fourth National Bank Bldg.  
Wichita, Kansas 67202

LOCATION: Balman "B" No. 1  
SE SE NW Section 21-20S-19W  
Pawnee County, Kansas

CONTRACTOR: **PICKRELL DRILLING COMPANY**  
Wichita, Kansas

Rotary Drilling Commenced 9-9-67  
Rotary Drilling Completed 9-21-67

CASING RECORD: (22 jts.) 8 5/8" surface casing set at 435' and cemented with 200 sacks cement. Circulated. (131 jts.) 5 1/2" casing set at 4268' and cemented with 125 sacks cement. Completed 1:20 AM, September 21, 1967.

LOG

(Figures indicate bottom of formation — measurements from top of rotary bushing.)

40	Soil & Post Rock		<u>C. F. S.</u>
435	Shale, Shells, Sand Streaks & Cement		4190'
550	Shale & Shells		4200'
756	Shale & Red Beds		4220'
906	Sand		4247'
1230	Shale & Sand Stringers		4266'
1303	Shale		4272'
1345	Anhydrite		
2835	Lime & Shale		
3360	Shale		<u>Slope Tests</u>
3695	Shale & Lime		3000'
3745	Heebner?		3500'
3766	Lime & Shale		4000'
4015	Lime		
4175	Lime & Shale		
4200	Lime		<u>S. L. M.</u>
4218	Sand & Shale		
4235	Sand	Board	3985.11
4266	Sand & Shale	Strap	3985.04
4272	Chert, RTD	Diff.	.07 (No Corr.)

RECEIVED  
STATE CORPORATION COMMISSION  
FEB 26 1968  
CONSERVATION DIVISION  
Wichita, Kansas

The undersigned, C. W. Sebitts, Attorney-in-Fact for PICKRELL DRILLING COMPANY, hereby certifies in behalf of said Company, that the above is a true and correct log of the formation encountered in drilling the above well as reflected by the Daily Drilling Reports.

PICKRELL DRILLING COMPANY  
By [Signature]  
C. W. Sebitts Attorney-in-Fact

STATE OF KANSAS }  
COUNTY OF SEDGWICK } ss.:

On this 28th day of September, 1967, before me the undersigned, a Notary Public, in and for the County and State aforesaid, personally appeared C. W. Sebitts, to me known to be the identical person who subscribed the name of PICKRELL DRILLING COMPANY to the foregoing instrument as its Attorney-in-Fact and acknowledged to me that he executed the same as his free and voluntary act and deed, and as the free and voluntary act and deed of such company, for the uses and purposes therein set forth.

Given under my hand and seal of office the day and year last above written.

My commission expires: May 10, 1970

[Signature]  
Notary Public  
L. M. Whiting

Copy To WLB  
12-21-67

ROTARY DRILLING LOG

15.145.20024.0000

COMPANY: Pickrell Drilling Company  
705 Fourth National Bank Bldg.  
Wichita, Kansas 67202

Rotary Drilling Commenced 9-9-67

Rotary Drilling Completed 9-21-67

LOCATION: Balman "B" No. 1  
SE SE NW Section 21-20S-19W  
Pawnee County, Kansas

CONTRACTOR: **PICKRELL DRILLING COMPANY**  
Wichita, Kansas

CASING RECORD: (22 jts.) 8 5/8" surface casing set at 435' and cemented with 200 sacks cement. Circulated. (131 jts.) 5 1/2" casing set at 4268' and cemented with 125 sacks cement. Completed 1:20 AM, September 21, 1967.

LOG

(Figures indicate bottom of formation — measurements from top of rotary bushing.)

40	Soil & Post Rock		<u>C. F. S.</u>
435	Shale, Shells, Sand Streaks & Cement		4190'
550	Shale & Shells		4200'
756	Shale & Red Beds		4220'
906	Sand		4247'
1230	Shale & Sand Stringers		4266'
1303	Shale		4272'
1345	Anhydrite		
2835	Lime & Shale		
3360	Shale		<u>Slope Tests</u>
3695	Shale & Lime		3000'
3745	Heebner?		3500'
3766	Lime & Shale		4000'
4015	Lime		
4175	Lime & Shale		
4200	Lime		<u>S. L. M.</u>
4218	Sand & Shale		
4235	Sand	Board	3985.11
4266	Sand & Shale	Strap	3985.04
4272	Chert, RTD	Diff.	.07 (No Corr.)

RECEIVED  
STATE CORPORATION COMMISSION  
MAR 1 1 1968  
CONSERVATION DIVISION  
Wichita, Kansas

The undersigned, C. W. Sebitts, Attorney-in-Fact for PICKRELL DRILLING COMPANY, hereby certifies in behalf of said Company, that the above is a true and correct log of the formation encountered in drilling the above well as reflected by the Daily Drilling Reports.

PICKRELL DRILLING COMPANY

By C. W. Sebitts Attorney-in-Fact

STATE OF KANSAS }  
COUNTY OF SEDGWICK } ss.:

On this 28th day of September, 19 67, before me the undersigned, a Notary Public, in and for the County and State aforesaid, personally appeared C. W. Sebitts, to me known to be the identical person who subscribed the name of PICKRELL DRILLING COMPANY to the foregoing instrument as its Attorney-in-Fact and acknowledged to me that he executed the same as his free and voluntary act and deed, and as the free and voluntary act and deed of such company, for the uses and purposes therein set forth.

Given under my hand and seal of office the day and year last above written.

My commission expires: May 10, 1970

L. M. Whiting  
Notary Public  
L. M. Whiting

