

STATE OF KANSAS  
STATE CORPORATION COMMISSION

Give All Information Completely  
Make Return Affidavit  
Mail - Deliver Report to:  
Conservation Division  
State Corporation Commission  
1111 Broadway  
Wichita, Kansas

WELL PLUGGING RECORD

Pawnee County. Sec. 21 Twp. 20S Rge. 19W (~~X~~) (W)

Location as "NE/CNW/SW" or footage from lines C NE SE

Lease Owner Jim Ralstin

Lease Name Thurman Well No. 1

Office Address 305 Orpheum Building, Wichita, Kans.

Character of Well (completed as Oil, Gas or Dry Hole) D & A

Date well completed July 27, 19 61

Application for plugging filed July 27, 19 61

Application for plugging approved July 27, 19 61


Plugging commenced July 27, 19 61

Plugging completed July 27, 19 61

Reason for abandonment of well or producing formation D & A

If a producing well is abandoned, date of last production \_\_\_\_\_ 19 \_\_\_\_\_

Was permission obtained from the Conservation Division or its agents before plugging was commenced? Yes

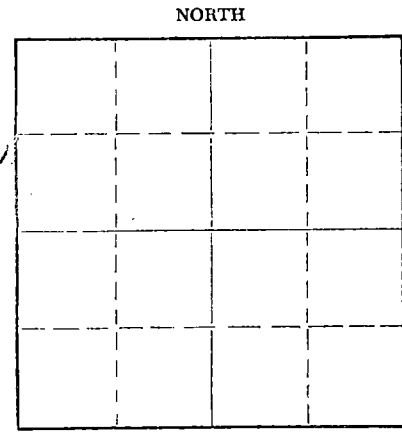

Locate well correctly on above Section Plat

Name of Conservation Agent who supervised plugging of this well Frank Broadfoot

Producing formation \_\_\_\_\_ Depth to top \_\_\_\_\_ Bottom \_\_\_\_\_ Total Depth of Well \_\_\_\_\_ Feet

Show depth and thickness of all water, oil and gas formations.

OIL, GAS OR WATER RECORDS

CASING RECORD

FORMATION	CONTENT	FROM	TO	SIZE	PUT IN	PULLED OUT
				8 5/8"	344'	-0-

Describe in detail the manner in which the well was plugged, indicating where the mud fluid was placed and the method or methods used in introducing it into the hole. If cement or other plugs were used, state the character of same and depth placed, from \_\_\_\_\_ feet to \_\_\_\_\_ feet for each plug set.

Set bottom plug at 320' with  
20 sx cement. Set top plug  
at 35' with 10 sx cement.

RECEIVED  
STATE CORPORATION COMMISSION

AUG 23 1961

CONSERVATION DIVISION  
Wichita, Kansas

(If additional description is necessary, use BACK of this sheet)

Name of Plugging Contractor Red Tiger Drilling Company

Address Box 173 - Russell, Kansas

STATE OF KANSAS, COUNTY OF SEDGWICK, ss.

Roy McClure (employee of owner) or (~~xxxxxx xxxxxx~~) of the above-described well, being first duly sworn on oath, says: That I have knowledge of the facts, statements, and matters herein contained and the log of the above-described well as filed and that the same are true and correct. So help me God.

(Signature) Roy McClure

580 Fourth Nat'l Bank Bldg., Wichita, Ks.  
(Address)

SUBSCRIBED AND SWORN TO before me this 31st day of July, 19 61

Marjorie Head  
Notary Public

My commission expires 11-17-62



DRILLERS LOG

No. 1 Thurman

CASING RECORD: 8 5/8" @ 344' w/200 sx cement  
 COMPANY: Jim Ralstin  
 CONTRACTOR: Red Tiger Drilling Co.  
 COMMENCED: July 15, 1961  
 COMPLETED: July 27, 1961  
 DESCRIPTION: C NE SE 21-208-19W Pawnee County Kansas  
 ELEVATION: 2220 DF 2223 RB

TOTAL DEPTH: 4229'

<u>FORMATION</u>	<u>FROM</u>	<u>TO</u>	<u>REMARKS</u>
Clay & Sand	0	100	
Shale & Shells	100	347	
Shale	347	615	
Shale Red Bed	615	780	
Sand	780	980	
Shells & Shale	980	1340	
Shale	1340	1348	
Anhydrite	1348	1375	
Shale	1375	1675	
Shale & Shells	1675	2140	
Shale & Lime	2140	2430	
Lime	2430	2515	
Lime & Shale	2515	3935	
Lime	3935	4045	
Lime & Shale	4045	4229	

RECEIVED  
 STATE CORPORATION COMMISSION  
 AUG 23 1961  
 CONSERVATION DIVISION  
 Wichita, Kansas

I certify that this is a true and correct copy of the above log to the best of my knowledge.

RED TIGER DRILLING COMPANY

Roy McClure  
 Roy McClure

Subscribed and sworn to before me this 31st day of July, 1961.

Wesley Head  
 Notary Public

My Commission Expires:  
11-17-62