

STATE OF KANSAS
STATE CORPORATION COMMISSION


Form CP-4

WELL PLUGGING RECORD

Give All Information Completely
Make Required Affidavit
Mail or Deliver Report to:
Conservation Division
State Corporation Commission
212 No. Market
Wichita, Kansas

~~XXXXXXX~~ Barton County. Sec. 30 Twp. 20S Rge. 11W (E) (W)

Location as "NE/CNW/SW" or footage from lines NE SE NE
Lease Owner Howard Alexander
Lease Name Luebbers Well No. 1
Office Address Box 1043, Tulsa, Oklahoma
Character of Well (completed as Oil, Gas or Dry Hole) Dry hole
Date well completed 9-27-66 19
Application for plugging filed 9-26-66 19
Application for plugging approved 9-26-66 19
Plugging commenced 9-26-66 19
Plugging completed 9-27-66 19
Reason for abandonment of well or producing formation Dry Hole

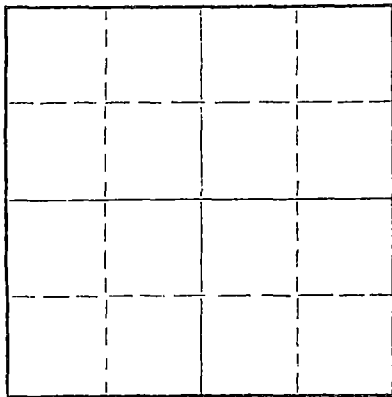

Locate well correctly on above
Section Plat

If a producing well is abandoned, date of last production _____ 19
Was permission obtained from the Conservation Division or its agents before plugging was commenced? yes

Name of Conservation Agent who supervised plugging of this well Donald Truan, Russell, Kansas 67665
Producing formation _____ Depth to top _____ Bottom _____ Total Depth of Well 3431 Feet
Show depth and thickness of all water, oil and gas formations.

OIL, GAS OR WATER RECORDS

CASING RECORD

FORMATION	CONTENT	FROM	TO	SIZE	PUT IN	PULLED OUT
				8 5/8"	269'	none

Describe in detail the manner in which the well was plugged, indicating where the mud fluid was placed and the method or methods used in introducing it into the hole. If cement or other plugs were used, state the character of same and depth placed, from _____ feet to _____ feet for each plug set.

Mudded to 260' with 1/2 sk. hulls, 25 sacks cement through drill pipe
Mudded to 40' with 1/2 sk. hulls, 12 sacks cement through drill pipe
put 3 sacks cement in rathole.

9-29-66
SEP 29 1966
CONSERVATION DIVISION
Wichita, Kansas

(If additional description is necessary, use BACK of this sheet)

Name of Plugging Contractor Leben Drilling, Inc.
Address Box 486, Great Bend, Kansas 67530

STATE OF KANSAS, COUNTY OF BARTON, ss.
Leslie Kite

(employee of owner) or (owner or operator) of the above-described well, being first duly sworn on oath, says: That I have knowledge of the facts, statements, and matters herein contained and the log of the above-described well as filed and that the same are true and correct. So help me God.

(Signature) Leslie Kite
Box 486, Great Bend, Kansas 67530
(Address)

SUBSCRIBED AND SWORN TO before me this 28th day of September, 19 66

My commission expires April 1, 1967

Glenda Neal
Notary Public.

DRILLER'S LOG

COMPANY: Howard Alexander
 CONTRACTOR: LEBEN DRILLING, INC.
 FARM: LUEBBERS #1
 LOCATION: NE SE NE SEC. 30-20S-11W
 BARTON COUNTY, KANSAS
 COMMENCED: 9-22-66
 COMPLETED: 9-27-66

0	40	Clay, Sand
40	170	Sand
170	195	Sand, Shale
195	271	Redbed, Shale
271	558	Redbed
558	570	Anhydrite
570	1360	Shale, Shells
1360	1475	Shale, Lime
1475	2073	Lime, Shale
2073	2525	Shale
2525	2787	Shale, Lime
2787	2935	Lime
2935	3097	Shale
3097	3380	Lime
3380	3431	Conglomerate
	<u>3431</u>	<u>RTD - D. & A.</u>

RECEIVED
 STATE CONSERVATION COMMISSION
 SEP 29 1966
 CONSERVATION DIVISION
 Wichita, Kansas

Set 8 5/8" used surface casing @ 269' with 275 sacks Common, 2% cc

I, Leslie Kite, do hereby certify that the above and foregoing is a true and correct copy of the log of the Luebbers #1 Well, located NE SE NE of Section 30, Township 20 South, Range 11 West, Barton County, Kansas, as reflected by the records of Leben Drilling, Inc.

Leslie Kite
 Leslie Kite

STATE OF KANSAS)
) SS
 COUNTY OF BARTON)

Subscribed and sworn to and before me, a Notary Public, in and for Barton County, Kansas, this 28th day of September, 1966.

Ulanda Nichols
 Ulanda Nichols

My Commission Expires:
 April 1, 1967