

STATE OF KANSAS
STATE CORPORATION COMMISSION


WELL PLUGGING RECORD

Give All Information Completely
Make Required Affidavit
Mail or Deliver Report to:
Conservation Division
State Corporation Commission
800 Bittling Building
Wichita, Kansas

Barton County. Sec. 30 Twp. 20 Rge. 11 ~~(E)~~ W (W)

Location as "NE/CNW/SW" or footage from lines C-NW-SE-SW
Lease Owner Prugh Petroleum Company
Lease Name Geo. Soeken "A" Lease Well No. 2
Office Address 907 Kennedy Bldg., Tulsa, Oklahoma
Character of Well (completed as Oil, Gas or Dry Hole) Oil Well
Date well completed March 14, 1948 19
Application for plugging filed 19
Application for plugging approved March 15, 1954 19
Plugging commenced April 6, 1954 19
Plugging completed April 9, 1954 19
Reason for abandonment of well or producing formation Stopped Producing

NORTH

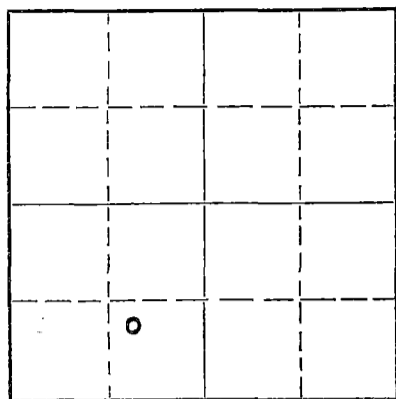

Locate well correctly on above
Section Plat

If a producing well is abandoned, date of last production _____ 19
Was permission obtained from the Conservation Division or its agents before plugging was commenced? Yes

Name of Conservation Agent who supervised plugging of this well _____
Producing formation Arbuckle Depth to top 3373 Bottom 3412 Total Depth of Well 3412 Feet
Show depth and thickness of all water, oil and gas formations.

OIL, GAS OR WATER RECORDS

CASING RECORD

FORMATION	CONTENT	FROM	TO	SIZE	PUT IN	PULLED OUT
				8 5/8"	300'	
				5 1/2"	3381'	2409'

Describe in detail the manner in which the well was plugged, indicating where the mud fluid was placed and the method or methods used in introducing it into the hole. If cement or other plugs were used, state the character of same and depth placed, from _____ feet to _____ feet for each plug set.

Filled with sand from TD to 3375', ran 5 sacks of cement from 3375' to 3350'. Pumped plug to 2392', pulled 77 joints (2409') of 5 1/2", filled with mud to 300', rock bridge from 300' to 285', ran 3 sacks cement to shut off water, 18 sacks of cement from 285' to 210', mudded from 210' to 40' rock bridge from 40' to 30', ran 10 sacks of cement from 30' to surface.

6-10-1954
RECEIVED
STATE CORPORATION COMMISSION
JUL 1 1954
CONSERVATION DIVISION

(If additional description is necessary, use BACK of this sheet), Kansas
Name of Plugging Contractor R & S Pipe Pulling Company
Address Ellinwood, Kansas

STATE OF Oklahoma, COUNTY OF Tulsa, ss.
I. G. H. Murray (employee of owner) or (owner or operator) of the above-described well, being first duly sworn on oath, says: That I have knowledge of the facts, statements, and matters herein contained and the log of the above-described well as filed and that the same are true and correct. So help me God.

(Signature) I. G. H. Murray
907 Kennedy Bldg., Tulsa, Oklahoma
(Address)

SUBSCRIBED AND SWORN TO before me this 9th day of June, 1954
July M. Beagel
Notary Public.

My Commission Expires Dec. 15, 1957
My commission expires _____

PLUGGING
FILE SEC 30-20 N 11W
PAGE 19 LINE 1

WELL LOG

Company Prugh Petroleum Company
 Farm Soeken No. 2

Sec. 30 T. 20 R. 11W
 NW SE SW

Total Depth 3387' County: Barton, Kansas
 Comm. 2-26-48 Comp. 3-14-48
 Shot or Treated
 Contractor Brunson Drilling Company
 Issued 5-15-48

CASING
 8-5/8" 300' Cem. w/150 sx
 5-1/2" 3379' Cem. w/200 sx

Elevation 1817 KB

Production Pot. 131 BOPD

no log 0-1610
 lime & shale 1805
 lime 1990
 lime & shale 2175
 shale & shells 2310
 lime & shale 2780
 lime 2825
 lime hrd 2870
 lime 3387
 Total Depth 3386

Top:
 Heebner 3021
 Brown lime 3122
 Lansing 3142
 Simpson 3366
 Arbuckle 3373

INDEXED
 FILED
 JUN 1 1954
 CONSERVATION DIVISION
 Wichita, Kansas

PLUGGING
 FILE SEC 30 T. 20 R. 11W
 BOOK PAGE 19 LINE 1