


WELL PLUGGING RECORD

Give All Information Completely  
Make Required Affidavit  
Mail or Deliver Report to:  
Conservation Division  
State Corporation Commission  
211 No. Broadway  
Wichita, Kansas

NORTH

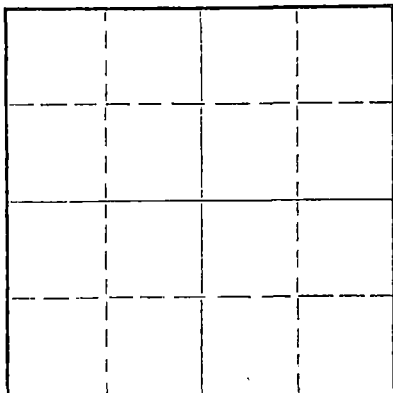

Locate well correctly on above  
Section Plat

Barton County. Sec. 30 Twp. 20 Rge. II W(E) (W)  
Location as "NE/CNW%SW%" or footage from lines SE NE SW  
Lease Owner V. E. Wiggins  
Lease Name Soeken Well No. 3  
Office Address P.O. Box 191 Mc Pherson, Kansas  
Character of Well (completed as Oil, Gas or Dry Hole) oil  
Date well completed 4-15 1948  
Application for plugging filed Feb 1964  
Application for plugging approved Feb 1964  
Plugging commenced Feb 18 1964  
Plugging completed Feb 22 1964  
Reason for abandonment of well or producing formation Went dry

If a producing well is abandoned, date of last production \_\_\_\_\_ 19\_\_\_\_  
Was permission obtained from the Conservation Division or its agents before plugging was commenced? Yes

Name of Conservation Agent who supervised plugging of this well Don Truan  
Producing formation \_\_\_\_\_ Depth to top \_\_\_\_\_ Bottom \_\_\_\_\_ Total Depth of Well \_\_\_\_\_ Feet  
Show depth and thickness of all water, oil and gas formations.

OIL, GAS OR WATER RECORDS

CASING RECORD

FORMATION	CONTENT	FROM	TO	SIZE	PUT IN	PULLED OUT
				5 1/2"		2,076'

Describe in detail the manner in which the well was plugged, indicating where the mud fluid was placed and the method or methods used in introducing it into the hole. If cement or other plugs were used, state the character of same and depth placed, from \_\_\_\_\_ feet to \_\_\_\_\_ feet for each plug set.

Plugged off bottom of hole with rock. Rock from 3320' to 3170'. Dumped 5 sx of cement. Mudded hole to 250'. Made 10' of rock bridge. Dumped 25 sx of cement. Mudded hole to 35'. Made 5' of rock bridge. Dumped 10 sx of cement, filling to the bottom of the celler.

RECEIVED  
STATE CORPORATION COMMISSION

MAR 13 1964

CONSERVATION DIVISION  
Wichita, Kansas

(If additional description is necessary, use BACK of this sheet)

Name of Plugging Contractor Art Lamb Casing Pulling Co.  
Address P.O. Box 983 Hutchinson, Kansas

STATE OF Kansas, COUNTY OF Reno, ss.  
Art Lamb (employee of owner) or (owner or operator) of the above-described well, being first duly sworn on oath, says: That I have knowledge of the facts, statements, and matters herein contained and the log of the above-described well as filed and that the same are true and correct. So help me God.

(Signature) [Signature]  
2809 Kings Dr. Hutchinson, Kansas  
(Address)

SUBSCRIBED AND SWORN TO before me this 12 th day of March, 1964

My commission expires January 5, 1966

[Signature]  
Notary Public.

KANSAS GEOLOGICAL SOCIETY  
 KANSAS WELL LOG BUREAU - KANSAS WELL SAMPLE BUREAU  
 KANSAS GEOLOGICAL SOCIETY BUILDING  
 508 EAST MURDOCK - WICHITA, KANSAS

15.009.14781.0000

OWNERSHIP

COMPANY **R.L. WILLIAMS**

SEC. 30 T. 20 R. 11W

Transferred to: V.E. Wiggins


SE NE SW

FARM **Soeken**

NO. 3

COUNTY **Barton**

KANSAS

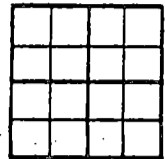

TOTAL DEPTH **3374'**

COMM. **4-4-48**

COMP. **4-15-48**

SHOT OR TREATED

CONTRACTOR

ISSUED **5-29-48**

CASING

20 10  
 15 8 5/8 261' w/150 sx cem.  
 12 6'  
 13 5 1/2 3370 1/2'

ELEVATION

PRODUCTION **223 BOPD**

FIGURES INDICATE BOTTOM OF FORMATIONS

sand, clay 30  
 sand, gravel 160  
 shale, shells 261  
 red bed, shale 470  
 shale, shells 560  
 anhydrite, lime 595  
 shale, shells 1080  
 salt, shale 1350  
 shale, shells 1460  
 lime 1480  
 shale, shells 1550  
 lime, shale 2785  
 shale, shells 2804  
 lime, shale 2890  
 lime brkn 2900  
 lime, shale 2955  
 lime 2985  
 shale, lime 3108  
 lime 3375  
 Total Depth

**RECEIVED**  
 STATE CORPORATION COMMISSION

MAR 13 1964

CONSERVATION DIVISION  
 Wichita, Kansas

Perforated  
 Baker Plug  
 TD

3188-3194  
 3320  
 3384

TOPS:  
 Topeka 2708  
 Heebner 2978  
 Brown lime 3112  
 Lansing 3130  
 Arbuckle 3354

~~3360-54~~  
 3170-54

250 - 240 - 252 ft

35 - 30 - 10 ft

CRM-18

Comp-22