


WELL PLUGGING RECORD

Give All Information Completely  
Make Required Affidavit  
Mail or Deliver Report to:  
Conservation Division  
State Corporation Commission  
800 Bittling Building  
Wichita, Kansas

Barton County. Sec. 27 Twp. 20S Rge. (E) 11 (W)  
Location as "NE/CNW $\frac{1}{4}$ SW $\frac{1}{4}$ " or footage from lines NW/4 NW/4 NE/4  
Lease Owner J. T. Phoenix  
Lease Name Peter Well No. 1  
Office Address 208 W. A, Ellinwood, Kansas  
Character of Well (completed as Oil, Gas or Dry Hole) dry hole  
Date well completed May 5 19 51  
Application for plugging filed May 5 19 51  
Application for plugging approved May 5 19 51  
Plugging commenced May 5 19 51  
Plugging completed May 5 19 51  
Reason for abandonment of well or producing formation dry  
If a producing well is abandoned, date of last production 19  
Was permission obtained from the Conservation Division or its agents before plugging was commenced? Yes

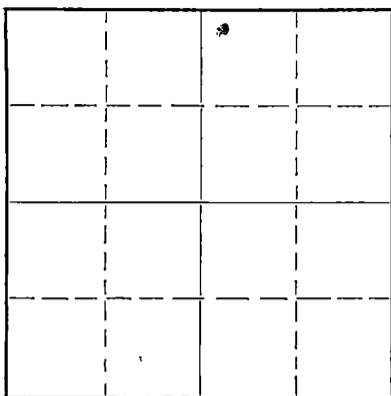

Locate well correctly on above Section Flat

Name of Conservation Agent who supervised plugging of this well C. D. Stough  
Producing formation arbuckle Depth to top 3328 Bottom 3360 Total Depth of Well 3360 Feet  
Show depth and thickness of all water, oil and gas formations.

OIL, GAS OR WATER RECORDS

CASING RECORD

Formation	Content	From	To	Size	Put In	Pulled Out
Kansas City <del>3110-3114</del>	slight stain	3110	3114	8 5/8	165'	
"	spotted stain & water	3130	3289			
Arbuckle	slight stain & water	3328	3360			

Describe in detail the manner in which the well was plugged, indicating where the mud fluid was placed and the method or methods used in introducing it into the hole. If cement or other plugs were used, state the character of same and depth placed, from.....feet to.....feet for each plug set.

Hole filled with mud to within 160' from top of well.  
Plug set at 160', then spotted through drill pipe with 15 sacks cement.  
Mudded to within 35' of top, then set plug and cemented to bottom of cellar. Plug set 10' from top of rat-hole and cemented to within 2' of top

6-1-51

(If additional description is necessary, use BACK of this sheet)

Correspondence regarding this well should be addressed to Ash-Mur Drilling Co.  
Address P. O. Box 211, Ellinwood, Kansas


STATE OF Kansas, COUNTY OF Barton, ss.  
B. E. J. Smith (employee of owner) or (owner or operator) of the above-described well, being first duly sworn on oath, says: That I have knowledge of the facts, statements, and matters herein contained and the log of the above-described well as filed and that the same are true and correct. So help me God.

(Signature) B. E. J. Smith

(Address) Ellinwood, Kansas

SUBSCRIBED AND SWORN to before me this 16 day of May, 1951

My commission expires Oct 28-1952 Notary Public.

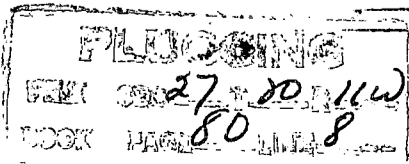

## WELL LOG

Peter #1, Barton County, Kansas

NW/4 NW/4 NE/4 Section 27- Township 20S- Range 11W

Figures indicate bottom of formation:

	0 -	70	sand	
		195	shale	
		475	shale and shells	
Elevation -		505	sand and redbed	
Well commenced	4-20-51	530	anhydrite	
Well completed	5-3-51	1390	shale and shells	
Surface pipe set	165'	1460	sandy shale	
		1785	lime and shale	
		1870	sandy lime and shale	
		2000	lime and shale	
		2415	shale and shells	
		2630	shale and lime	
		2815	lime and shale	
		2975	lime	
		3002	shale	
		3051	lime and shale	
		3328	lime	
		3360	arbuttle	total depth

RECEIVED  
STATE CORPORATION COMMISSION

JUN - 1 1951

PLUGGING  
BOOK PAGE 80 LINE 8