


WELL PLUGGING RECORD

Give All Information Completely
Make Required Affidavit
Mail or Deliver Report to:
Conservation Division
State Corporation Commission
800 Bitting Building
Wichita, Kansas

NORTH

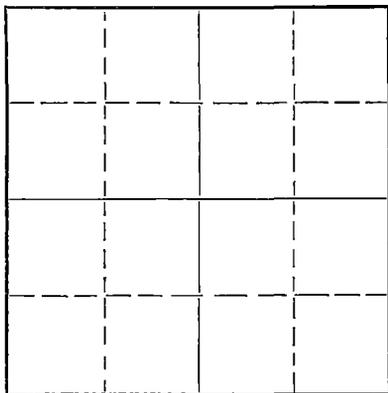

Locate well correctly on above
Section Plat

Barton County. Sec. 28 Twp. 20S Rge. 11W (E) (W)
Location as "NE/CNW $\frac{1}{4}$ SW $\frac{1}{4}$ " or footage from lines NW NW SE
Lease Owner Pickrell Drilling Company et al
Lease Name Rugan Well No. 1
Office Address 705 Fourth Nat'l. Bank Bldg., Wichita, Ks.
Character of Well (completed as Oil, Gas or Dry Hole) Dry Hole
Date well completed 7/7/ 1951
Application for plugging filed 7/6/ 1951
Application for plugging approved 7/6/ 1951
Plugging commenced 7/6/ 1951
Plugging completed 7/7/ 1951
Reason for abandonment of well or producing formation D. & A.

If a producing well is abandoned, date of last production..... 19.....

Was permission obtained from the Conservation Division or its agents before plugging was commenced? Yes

Name of Conservation Agent who supervised plugging of this well Mr. Stough

Producing formation..... Depth to top..... Bottom..... Total Depth of Well 3390' Feet

Show depth and thickness of all water, oil and gas formations.

OIL, GAS OR WATER RECORDS

CASING RECORD

Formation	Content	From	To	Size	Put In	Pulled Out
				8 5/8"	275'	None
			No Oil string was run.			

Describe in detail the manner in which the well was plugged, indicating where the mud fluid was placed and the method or methods used in introducing it into the hole. If cement or other plugs were used, state the character of same and depth placed, from..... feet to..... feet for each plug set.

Filled hole with heavy drilling mud to 270', bridged hole and cemented w/ 15 sax. Fill with heavy mud to 40' and cement w/ 10 sax to bottom of cellar.

RECEIVED
STATE CORPORATION COMMISSION
JUL 21 1951
CONSERVATION DIVISION
Wichita, Kansas

(If additional description is necessary, use BACK of this sheet)

Name of Plugging Contractor Pickrell Drilling Company
Address 705 Fourth Nat'l. Bank Bldg., Wichita, Ks.

STATE OF Kansas, COUNTY OF Sedgwick, ss.

C. W. Sebitts, attorney-in-fact (employee of owner) or (owner or operator) of the above-described well, being first duly sworn on oath, says: That I have knowledge of the facts, statements, and matters herein contained and the log of the above-described well as filed and that the same are true and correct. So help me God.

(Signature) [Signature]

705 Fourth Nat'l. Bank Bldg., Wichita, Ks.
(Address)

SUBSCRIBED AND SWORN TO before me this 14th day of July, 1951.

[Signature]
Notary Public.

My commission expires Jan. 28, 1953

23-8390-5 6-51-20M

PLUGGING
FILE SEC. 28 T 20 R 11W
BOOK PAGE 94 LINE 36

COMPANY: PICKRELL DRILLING COMPANY, ET AL. Rotary Drilling Commenced: 6-28-51
 Wichita, Kansas Rotary Drilling Completed: 7-7-51

LOCATION: RUGAN #1, NW NW SE
 Sec. 28-20S-11W, Barton County, Kansas

CONTRACTOR: PICKRELL DRILLING COMPANY
 Wichita, Kansas

CASING RECORD: 9 Jts. 8 5/8" Nat'l. 24 1/2 Smls. Casing set at 275', cemented with
 150 sacks cement. Cement circulated.

LOG

(Figures indicate bottom formation - measurements from top rotary bushings.)

Clay	30	Circulate for samples at	3154'
Sand & Shale	185	" " " "	3176'
Shale & Shells	250	" " " "	3326'
Shale	517	" " " "	3336'
Anhydrite	545	" " " "	3343'
Shale & Shells	1190	" " " "	3348'
Salt	1330	" " " "	3350'
Shale & Shells	1365	" " " "	3355'
Shale & Lime	2320		
Shale & Shells	2425	Slope Test at 1,000'	- 0° off.
Shale & Lime	2535	" " " 1,500'	- 0° off.
Shale & Lime Shells	2655	" " " 2,000'	- 0° off.
Lime & Shale	2830	" " " 2,500'	- 0° off.
Lime	2940	" " " 3,000'	- 0° off.
Hebner	2945		
Shale & Lime	3125	S.L.M. at 3,000'	- OK.
Lime	3341		
Arbuckle Lime	3390	Rotary T.D.	

The undersigned, C. W. Sebitts, Attorney-In-Fact for PICKRELL DRILLING COMPANY, hereby certifies in behalf of said Company, that the above log is a true and correct log of the formation encountered in drilling the above well as reflected by the Daily Drilling Reports.

PICKRELL DRILLING COMPANY

By *C. W. Sebitts*
 Attorney-In-Fact

STATE OF KANSAS)
 COUNTY OF SEDGWICK) SS

BE IT REMEMBERED that on this 17th day of July, 1951, before me, the undersigned, a Notary Public, duly commissioned, in and for the county and state aforesaid, came C. W. Sebitts, Attorney-In-Fact, and to be the same person who executed the foregoing instrument of writing in behalf of said Company, and he duly acknowledged the execution of the same for himself and for said Company.

IN WITNESS WHEREOF, I have hereunto set my hand and official seal on the day and year last above written.

Ethel Zimmerman
 Notary Public
 CONSERVATION DIVISION
 WICHITA, KANSAS
 JUL 21 1951

My commission expires January 28, 1953.

PLUGGING
 FILE SEC 28 T 50R 110
 BOOK PAGE 24 LINE 36