


WELL PLUGGING RECORD

Give All Information Completely
Make Required Affidavit
Mail or Deliver Report to:
Conservation Division
State Corporation Commission
211 No. Broadway
Wichita, Kansas

Barton County. Sec. 29 Twp. 20S Rge. 12W (E) (W)

Location as "NE/CNW%SW%" or footage from lines SE SW SW
Lease Owner E. K. Edmiston
Lease Name Jackson Simpson Well No. 1
Office Address Union National Bldg., Wichita, Kansas
Character of Well (completed as Oil, Gas or Dry Hole) Dry Hole
Date well completed May 3 19 59
Application for plugging filed _____ 19 _____
Application for plugging approved 5-3 May 3 19 59
Plugging commenced May 3 19 59
Plugging completed May 3 19 59
Reason for abandonment of well or producing formation Failure to produce
in commercial quantities
If a producing well is abandoned, date of last production _____ 19 _____
Was permission obtained from the Conservation Division or its agents before plugging was commenced? Yes

NORTH

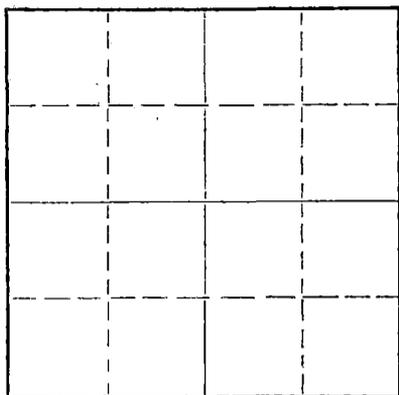

Locate well correctly on above Section Plat

Name of Conservation Agent who supervised plugging of this well Don Truan
Producing formation _____ Depth to top _____ Bottom _____ Total Depth of Well 3565 Feet
Show depth and thickness of all water, oil and gas formations.

OIL, GAS OR WATER RECORDS

CASING RECORD

FORMATION	CONTENT	FROM	TO	SIZE	PUT IN	PULLED OUT
				8 5/8	257'	

Describe in detail the manner in which the well was plugged, indicating where the mud fluid was placed and the method or methods used in introducing it into the hole. If cement or other plugs were used, state the character of same and depth placed, from _____ feet to _____ feet for each plug set.

Bottom Plug @ 250' with 1/3 sack hulls plus 25 sacks cement
Filled hole to 40' with mud-plug and 1/3 sack hulls and 10 sacks cement

RECEIVED
STATE CORPORATION COMMISSION
AUG 3 1959
CONSERVATION DIVISION
Wichita, Kansas

(If additional description is necessary, use BACK of this sheet)

Name of Plugging Contractor _____
Address _____

STATE OF KANSAS, COUNTY OF SEDGWICK, ss.
Richard A. Shelley (employee of owner) or (owner or operator) of the above-described well, being first duly sworn on oath, says: That I have knowledge of the facts, statements, and matters herein contained and the log of the above-described well as filed and that the same are true and correct. So help me God.

(Signature) Richard A. Shelley
205 Miller Building, Wichita, Kansas
(Address)

SUBSCRIBED AND SWORN TO before me this 31st day of July, 19 59
Leona M. Howers
Notary Public.

My commission expires March 24, 1960

PLUGGING
FILE SEC 29 T 20 R 12 W
BOOK PAGE 54 LINE 20

COMPANY: E. K. Edmiston
802 Union National Bldg
Wichita, Kansas

Rotary Drilling Commenced: 4-23-59
Rotary Drilling Completed: 5- 3-59

LOCATION: Simpson No. 1
SE SW SW Sec. 29-20S-12W
Barton County, Kansas

CONTRACTOR: Shelley-Miller Drilling Company
205 Miller Building
Wichita, Kansas

CASING RECORD: 8 5/8" csg set @ 257', cemented with 195 sacks cement.

LOG
(Measurements from top of Rotary Bushing to bottom of formation)

Sand and Clay	205
Red Bed	659
Anhydrite	885
Shale and Shells	1,425
Lime and Shale	2,415
Shale and Shells	2,655
Lime and Shale	2,920
Lime	3,565

RECEIVED
STATE CORPORATION COMMISSION
SEP 3 1959
CONSERVATION DIVISION
Wichita, Kansas

The undersigned, Richard A. Shelley, Partner of Shelley-Miller Drilling Company, hereby certifies in behalf of said company, that the above log is a true and correct log of the formation encountered in drilling the above well as reflected by the Daily Drilling Reports.

SHELLEY-MILLER DRILLING COMPANY

By Richard A. Shelley

STATE OF KANSAS)
COUNTY OF SEDGWICK) SS

BE IT REMEMBERED, that on this 6th day of May, 1959, before me, the undersigned, a Notary Public, duly commissioned in and for the county and state aforesaid, came Richard A. Shelley, Partner, and known to me to be the same person who executed the foregoing instrument of writing in behalf of Shelley-Miller Drilling Company, as a Partner of said company, and he duly acknowledged the execution of the same for himself and for said company.

IN WITNESS WHEREOF, I have hereunto set my hand and official seal on the day and year last above written.

Lorana M. Bowen
Notary Public



My Commission Expires: March 24 1960

PLUGGING
FILE SEC. 29 T. 20 R. 24
BOOK PAGE 54 LINE 20