


WELL PLUGGING RECORD

Give All Information Completely
Make Required Affidavit
Mail or Deliver Report to:
Conservation Division
State Corporation Commission
800 Bittig Building
Wichita, Kansas

..... Barton County. Sec. 29 Twp. 20 Rge. 12 (E)..... (W)
Location as "NE/CNW $\frac{1}{4}$ SW $\frac{1}{4}$ " or footage from lines SW Cor SW $\frac{1}{4}$
Lease Owner S. A. Murphy et al
Lease Name Simpson Well No. 1
Office Address 701 Brown Bldg., Wichita 2, Kansas
Character of Well (completed as Oil, Gas or Dry Hole) dry hole
Date well completed January 5 19 51
Application for plugging filed January 19 19 51
Application for plugging approved January 19 19 51
Plugging commenced January 19 19 51
Plugging completed January 19 19 51
Reason for abandonment of well or producing formation dry

NORTH

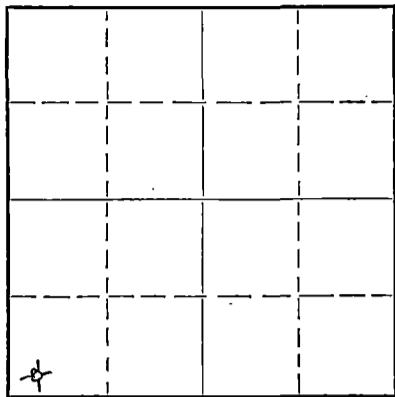

Locate well correctly on above
Section Flat

If a producing well is abandoned, date of last production 19.....
Was permission obtained from the Conservation Division or its agents before plugging was com-
menced? yes

Name of Conservation Agent who supervised plugging of this well C. D. Stough, Box 207, Great Bend, Kansas
Producing formation Depth to top Bottom Total Depth of Well 2505 Feet
Show depth and thickness of all water, oil and gas formations.

OIL, GAS OR WATER RECORDS

CASING RECORD

Formation	Content	From	To	Size	Put In	Pulled Out
				8-5/8"	271	none
				5 1/8"	3466	2739' 6"

Describe in detail the manner in which the well was plugged, indicating where the mud fluid was placed and the method or methods used in introducing it into the hole. If cement or other plugs were used, state the character of same and depth placed, from feet to feet for each plug set.

3250 to 3230 feet - sand bridge
3230 to 3200 " 5 sks. cement
3200 to 287 " Mudded
287 to 275 " Rock Bridge
275 to 240 " 15 sks. cement
240 to 25 " Mud
25 to cellar " 10 sks. cement

RECEIVED
STATE CORPORATION COMMISSION
FEB - 1 1951
CONSERVATION DIVISION
Wichita, Kansas

(If additional description is necessary, use BACK of this sheet)

Correspondence regarding this well should be addressed to Virginia Drilling Co., Inc.
Address 701 Brown Bldg., Wichita 2, Kansas

STATE OF Kansas, COUNTY OF Sedgwick, ss.
S. A. Murphy (employee of owner) or (owner or operator) of the above-described well,

being first duly sworn on oath, says: That I have knowledge of the facts, statements, and matters herein contained and the log of the above-described well as filed and that the same are true and correct. So help me God.

(Signature) *S. A. Murphy*
701 Brown Bldg., Wichita 2, Kansas
(Address)

SUBSCRIBED AND SWORN TO before me this 31st day of January, 19 51

My commission expires March 15, 1954

PLUGGING
FILE SEC 29 T 20 R 124
BOOK PAGE 57 LINE 24

Well: Simpson #1
 Location: SW SW SW Section 29-20-12, Barton County, Kansas
 Company: S. A. Murphy et al
 Contractor: Virginia Drilling Co., Inc.
 Commenced: December 9, 1950
 Completed: January 5, 1951
 Total Depth: 3505
 Elevation: 1863 K.B.

FORMATION	DEPTH	
Sand-clay	0-230	Set 8-5/8" csg. @ 271'
Red Bed-shale	230-467	Set 5 1/2" csg. @ 3466'
Red Bed	467-680	
Anhydrite	680-714	
Shale w/lime strks.	714-1170	
Shale-shells	1170-1290	
Salt-shells	1290-1380	
Brk. Lime-shale	1380-1530	TOPS:
Lime	1530-1645	Brown Lime 3210'
Lime-shale	1645-1851	White Lansing 3225'
Lime	1851-1885	Base Kansas City 3451'
Broken Lime	1885-2005	Arbuckle 3460
Lime-shale	2005-2155	
Lime	2155-2185	
Brk. Lime-shale	2185-2270	
Shale-shells	2270-2400	
Shale w/lime strks.	2400-2585	
Shale-shells	2585-2700	
Shale-lime	2700-2800	
Lime	2800-2986	
Broken Lime-shale	2986-3008	
Lime	3008-3065	
Lime-shale	3065-3110	
Lime	3110-3135	
Shale-Brk. Lime	3135-3160	
Shale	3160-3185	
Shale-lime	3185-3255	
Lime	3255-3345	
Lime-shale	3345-3400	
Lime	3400-3451	
Shale	3451-3454	
Chert-lime	3454-3460	
Dolomite	3460-3505	

STATE CORPORATION COMMISSION
 FEB - 1 1951
 CONSERVATION DIVISION
 - Wichita, Kansas

Now comes S. A. Murphy, who states that he is familiar with the drilling of oil and gas wells and knows of his own knowledge that the Simpson #1 located in the SW SW SW Sec. 29-20-12, Barton County, Kansas, was drilled to a total depth of 3505 feet. Same was plugged and abandoned.

S. A. Murphy

Subscribed and sworn to before me this 31st day of January, 1951.

My commission expires March 15, 1954.

Inez M. Newman

PLUGGING
 FILE SEC 29-20-12
 BOOK PAGE 57 LINE 24