


STATE OF KANSAS
STATE CORPORATION COMMISSION

Give All Information Completely
Make Required Affidavit
Mail or Deliver Report to:
Conservation Division
State Corporation Commission
211 No. Broadway
Wichita, Kansas

WELL PLUGGING RECORD

Barton County, Sec. 31 Twp. 20 Rge. 11 (E) (W)

Location as "NE/CNW%SW%" or footage from lines SE 4
Lease Owner H. C. Bennett
Lease Name Fischer Well No. 1
Office Address 1212 Union National Bldg., Wichita, Kansas
Character of Well (completed as Oil, Gas or Dry Hole) oil well
Date well completed _____ 19____
Application for plugging filed 7-2-65 19____
Application for plugging approved 7-4-65 19____
Plugging commenced 7-7-65 19____
Plugging completed 7-13-65 19____
Reason for abandonment of well or producing formation depleted

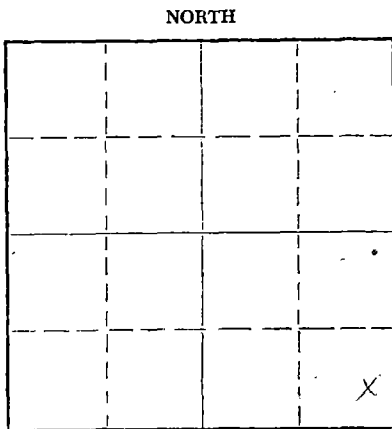

Locate well correctly on above Section Plat

If a producing well is abandoned, date of last production _____ 19____
Was permission obtained from the Conservation Division or its agents before plugging was commenced? yes

Name of Conservation Agent who supervised plugging of this well Donald Truan
Producing formation _____ Depth to top _____ Bottom _____ Total Depth of Well 3365 Feet
Show depth and thickness of all water, oil and gas formations.

OIL, GAS OR WATER RECORDS

CASING RECORD

| FORMATION | CONTENT | FROM | TO | SIZE | PUT IN | PULLED OUT |
|-----------|---------|------|----|--------|--------|------------|
| | | | | 10 3/4 | 242 | none |
| | | | | 7 | 3365 | 1527.15 |
| | | | | | | |
| | | | | | | |
| | | | | | | |
| | | | | | | |
| | | | | | | |
| | | | | | | |
| | | | | | | |

Describe in detail the manner in which the well was plugged, indicating where the mud fluid was placed and the method or methods used in introducing it into the hole. If cement or other plugs were used, state the character of same and depth placed, from _____ feet to _____ feet for each plug set.

Fill hole with chat to 3190' and dump 5 sacks cement.
Set 15' rock bridge from 185' to 170' and mixed and dumped 4 sacks cement and 2 sacks calseal. Let cement and calseal set up. Bailed hole down and dumped 26 sacks cement. Mud hole to 30' and dump 15 sacks cement.

RECEIVED
STATE CORPORATION COMMISSION
JUL 27 1965
CONSERVATION DIVISION
Wichita, Kansas

(If additional description is necessary, use BACK of this sheet)
Name of Plugging Contractor Flint Engineering & Construction Company
Address Box 950, El Dorado, Kansas

STATE OF KANSAS, COUNTY OF BUTLER, ss.

(employee of owner) or (owner or operator) of the above-described well, being first duly sworn on oath, says: That I have knowledge of the facts, statements, and matters herein contained and the log of the above-described well as filed and that the same are true and correct. So help me God.

(Signature) James Bawdle
El Dorado, Kansas
(Address)

SUBSCRIBED AND SWORN to before me this 20th day of July, 19 65

My commission expires 9-27-67

Ronald R. Harrison
Notary Public.