

STATE OF KANSAS
STATE CORPORATION COMMISSION


WELL PLUGGING RECORD

OR
FORMATION PLUGGING RECORD

Strike out upper line when reporting plugging off formations.

Give All Information Completely
Make Required Affidavit
Mail or Deliver Report to:
Conservation Division
State Corporation Commission
890 Bittling Building
Wichita, Kansas

Barton County. Sec. 31 Twp. 20 Rge. 11 (E) 11 (W)
Location as "NE $\frac{1}{4}$ NW $\frac{1}{4}$ SW $\frac{1}{4}$ " or footage from lines SE $\frac{1}{4}$ SE $\frac{1}{4}$ (660' from E line
Lease Owner G W Keyes Drilling Co. et al 500' from S line)
Lease Name Ringering Well No. 1
Office Address Ellinwood, Kansas
Character of Well (completed as Oil, Gas or Dry Hole) Dry hole
Date well completed 7-29-48 1948
Application for plugging filed 7-29-48 1948
Application for plugging approved 7-29-48 1948
Plugging commenced 7-29-48 1948
Plugging completed 7-29-48 1948
Reason for abandonment of well or producing formation Dry hole

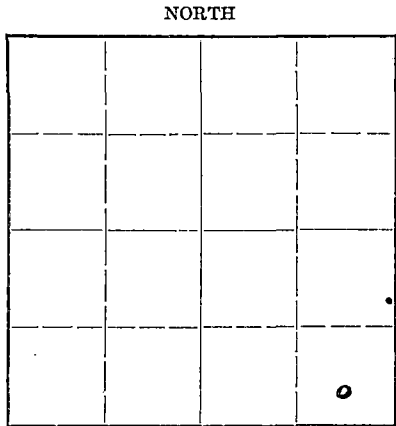

Locate well correctly on above Section Plat

Name of Conservation Agent who supervised plugging of this well C. D. Stough
Producing formation none Depth to top none Bottom -- Total Depth of Well 3127 Feet
Show depth and thickness of all water, oil and gas formations.

OIL, GAS OR WATER RECORDS

CASING RECORD

Formation	Content	From	To	Size	Put In	Pulled Out
Surface pipe		0	217	8 5/8"	217	none

Describe in detail the manner in which the well was plugged, indicating where the mud fluid was placed and the method or methods used in introducing it into the hold. If cement or other plugs were used, state the character of same and depth placed, from _____ feet to _____ feet for each plug set.

Filled hole with heavy mud to 217' and set bridge at 217'; cemented with 15 sacks on top of bridge. Set plug at 25', and cemented with 10 sacks on top of bridge, cement returning to base of cellar.

7-2-1948
JUL 2 1948

(If additional description is necessary, use BACK of this sheet)
Correspondence regarding this well should be addressed to G W Keyes Drilling Company
Address Ellinwood, Kansas

STATE OF Kansas, COUNTY OF Barton, ss.
I J Rader (employee of owner) of the above-described well,
being first duly sworn on oath, says: That I have knowledge of the facts, statements, and matters herein contained and the log of the above-described well as filed and that the same are true and correct. So help me God.
(Signature) I J Rader
Ellinwood, Kansas (Address)

SUBSCRIBED AND SWORN to before me this 31st day of July, 1948

My commission expires Feb. 10, 1951

George A. Meyer
Notary Public.

31 20 11W
47 2

WELL LOG

15.009.65623.0000

G W Keyes Drilling Co. et al, Owners - Ringering No. 1
Gen. SL SE/4 SE/4 Section 31, Township 20S, Range 11 West,
Barton County, Kansas

Figures indicate bottom of formation

0	to	28	clay
		45	sand
		185	sand and shale
		217	shale and shells
		480	red bed
		578	sand and shale
		603	anhydrite
		1090	shale and shells
		1315	salt
		1545	shale and shells
		1565	sand
		1795	shale and shells
		2050	lime and shale
		2265	shale and shells
		2720	shale
		2810	lime
		2850	lime and shale
		2883	porous lime
		2932	lime and shale
		3000	shale and lime
		3080	lime and shale
		3129	shale and lime
		3240	lime
		3350	lime and shale
		3427	lime
		3427	Total Depth D&A

Elevation 1812 DF

Tops corrected 3' to derrick floor

Arbuckle 3401

Pipe Record

8 5/8" set at 217'

Commenced 7-21-48

Completed 7-30-48

State of Kansas)
County of Barton) SS

I, I. J. Rader, Employee of the G W Keyes Drilling Company, being first duly sworn on oath, declare: That I have knowledge of the facts, statements and matters herein contained pertaining to the log of the above-described well, as filed, and that the same are true and correct.

I. J. Rader

Subscribed and Sworn to before me this 31st day of July, 1948.

George A. Meyer
Notary Public

My commission expires Feb. 10, 1951.

