


STATE OF KANSAS
STATE CORPORATION COMMISSION

WELL PLUGGING RECORD

Give All Information Completely
Make Required Affidavit
Mail or Deliver Report to:
Conservation Division
State Corporation Commission
800 Bitting Building
Wichita, Kansas

Barton County, Sec. 31 Twp. 20 Rge. 11W ~~XXXXXX~~

Location as "NE/CNW/4SW/4" or footage from lines NW NE NW
Lease Owner Imperial Petroleum Company, Inc.
Lease Name Musenberg Well No. 1
Office Address 903 Union Nat'l. Bank Bldg., Wichita, Kansas
Character of Well (completed as Oil, Gas or Dry Hole) Dry Hole
Date well completed January 11 1952
Application for plugging filed January 11 1952
Application for plugging approved January 11 1952
Plugging commenced January 11 1952
Plugging completed January 11 1952
Reason for abandonment of well or producing formation
Oil in commercial quantities not found.
If a producing well is abandoned, date of last production - - - 19
Was permission obtained from the Conservation Division or its agents before plugging was commenced? Yes

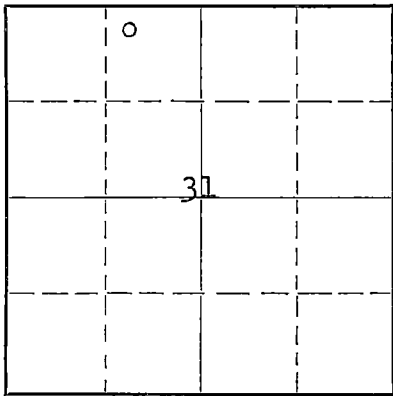

Locate well correctly on above Section Plat

Name of Conservation Agent who supervised plugging of this well C.D. Stough, Great Bend, Kansas
Producing formation - - - Depth to top - - - Bottom - - - Total Depth of Well 3940 Feet
Show depth and thickness of all water, oil and gas formations.

OIL, GAS OR WATER RECORDS

CASING RECORD

Formation	Content	From	To	Size	Put In	Pulled Out
			218'	8 5/8"	218'	None

Describe in detail the manner in which the well was plugged, indicating where the mud fluid was placed and the method or methods used in introducing it into the hole. If cement or other plugs were used, state the character of same and depth placed, from - - - feet to - - - feet for each plug set.

Filled hole with heavy mud to 210'. Set #1 Plug W/15 Sks. Cement. Filled hole with heavy mud to 40'. Set #2 Plug W/10 Sks. Cement to Bottom Cellar.

RECEIVED
STATE CORPORATION COMMISSION
JAN 16 1952
CONSERVATION DIVISION
Wichita, Kansas

(If additional description is necessary, use BACK of this sheet)

Correspondence regarding this well should be addressed to Imperial Petroleum Company, Inc.
Address 903 Union National Bank Bldg., Wichita 2, Kansas

STATE OF KANSAS, COUNTY OF SEDGWICK, ss.
Raymond L. Bacon (employee of owner) of the above-described well, being first duly sworn on oath, says: That I have knowledge of the facts, statements, and matters herein contained and the log of the above-described well as filed and that the same are true and correct. So help me God. IMPERIAL PETROLEUM COMPANY, INC.
(Signature) By: *Raymond L. Bacon* Sec-Treas.
Wichita, Kansas (Address)

SUBSCRIBED AND SWORN TO before me this 15th day of January, 1952

Frederick F. Little
Notary Public.

My commission expires January 4, 1954

23-3273-3 4-50-10M
PLUGGING
FILE SEC 31-1-20-2-11W
BOOK PAGE 137 LINES 27

DRILLER'S LOG

Imperial Petroleum Company, Inc.
 903 Union National Bank Bldg.
 Wichita 2, Kansas

#1 Musenberg
 NW NE NW
 31-20S-11W
 Barton County, Kansas

Total Depth: 3490'

PRODUCTION: D & A

Date Commenced: 1-2-52 Date Completed: 1-11-52

Casing Record: Set 218' of 8 5/8" w/250 Sacks Cement.

TOPS

Heebner	3016 (-1193)
Brown Lime	3149 (-1326)
Lansing	3164 (-1341)
Conglomerate	3380 (-1557)
Simpson	3428 (-1605)
Arbuckle	3473 (-1650)
R.T.D.	3490 (-1657)

Figures Indicate Bottom of Formations:

Sand	130'
Sand & Shale	218'
Red Bed & Shells	770'
Shale & Shells	1410'
Lime & Shale	2780'
Lime	3087'
Lime & Shale	3180'
Lime	3420'
Conglomerate	3474'
Arbuckle	3490'

Total Depth (Rotary) 3490'

STATE OF KANSAS
 DEPARTMENT OF GEOLOGY
 DIVISION OF OIL AND GAS
 WICHITA, KANSAS
 JAN 16 1952

We hereby certify this to be a correct and accurate log of the above described well as shown on the daily drilling reports.

IMPERIAL PETROLEUM COMPANY, INC.

By: C. R. Mayfield
 C. R. Mayfield, Geologist

Subscribed and sworn to before me this 15th day of January, 1952.

Marguerite Little
 Notary Public

My Commission Expires:

January 4, 1954

PLUGGING
 FILE SEC 31-T-20 R100
 BOOK PAGE 137 LINE 27