

WELL PLUGGING RECORD


FORMATION PLUGGING RECORD

STATE OF KANSAS
STATE CORPORATION COMMISSION
Give All Information Completely
Make Required Affidavit
Mail or Deliver Report to:
Conservation Division
State Corporation Commission
800 Bitting Building
Wichita, Kansas

Strike out upper line
when reporting plug-
ging off formations.

Barton County, Sec. 32 Twp. 20S Rge. 11 (W)

Location as "NE 1/4 NW 1/4 SW 1/4" or footage from lines NW SE NW
Lease Owner The Bay Petroleum Corporation
Lease Name Kowalsky Well No. 2
Office Address Box 957, Denver, Colorado
Character of Well (completed as Oil, Gas or Dry Hole) Dry Hole
Date well completed June, 29, 1949
Application for plugging filed July, 29, 1949
Application for plugging approved July, 30, 1949
Plugging commenced August, 22, 1949
Plugging completed August, 25, 1949
Reason for abandonment of well or producing formation Dry Hole

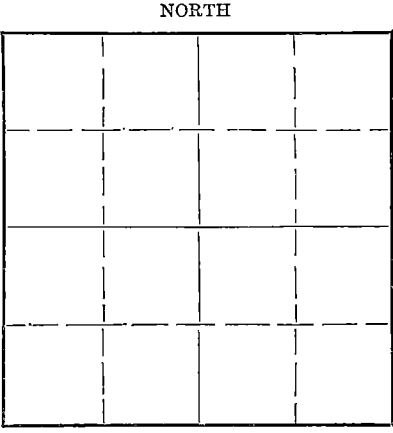

Locate well correctly on above Section Plat

Name of Conservation Agent who supervised plugging of this well Mr. Stough
Producing formation Arbuckle (test) Depth to top 3372' Bottom 3410 1/2' Total Depth of Well 3410 1/2' Feet
Show depth and thickness of all water, oil and gas formations.

OIL, GAS OR WATER RECORDS

CASING RECORD

Table with 7 columns: Formation, Content, From, To, Size, Put In, Pulled Out. Contains data for 8 5/8" OD and 5 1/2" OD casing.

Describe in detail the manner in which the well was plugged, indicating where the mud fluid was placed and the method or methods used in introducing it into the hole. If cement or other plugs were used, state the character of same and depth placed, from feet to feet for each plug set.

Aug. 22, 1949 - Ran 34' of rock and 5 sacks of cement to bottom of hole.
Aug. 25, 1949 - Mudded hole, set bridge at 250', ran 15 sacks of cement. Mudded hole and ran 10 sacks of cement to base of cellar.

RECEIVED
AUG 31 1949
STATE CORPORATION COMMISSION
KANSAS

(If additional description is necessary, use BACK of this sheet)

Correspondence regarding this well should be addressed to The Bay Petroleum Corporation,
Address Box 513, Chase, Kansas.

STATE OF Kansas, COUNTY OF Rice, ss.
Forrest Crawford, (employee of owner) or (owner or operator) of the above-described well,
being first duly sworn on oath, says: That I have knowledge of the facts, statements, and matters herein contained and the log of the above-described well as filed and that the same are true and correct. So help me God.

(Signature) Forrest Crawford

(Address)

SUBSCRIBED AND SWORN to before me this 29th day of August, 1949

Notary Public signature

My commission expires May, 20, 1950

CC/Anderson-Pritchard
314 Orpheum Bldg, Wichita,
Bay - Denver
Bay - Wichita
Bay - Chase

PLUGGING
FILE SEC 32 T 20 R 11W
BOOK PAGE 167 LINE 31

THE BAY PETROLEUM CORPORATION

Kowalsky # 2

NW-SE-NW Section 32-20-11

Barton County, Kansas

Com. Rig up	: 5-15-1949	Elevation	:
Com. Drilling	: 5-17-1949	Initial Production:	:
Completed R. D.	: 6-3 -1949	Contractor	: C. E. Ash
		Tools	: Rotary
T. D. Rotary Hole :		3377'	

CASING RECORD

<u>Run</u>	<u>Pulled</u>	<u>Left in hole</u>
582'	8 5/8 Surface Pipe (cemented with 350 sacks)	582' 8 5/8 Surface Pipe
3373'	5 1/2 15# Casing (cemented with 100 sacks)	3373' 5 1/2 Casing

<u>STRATA</u>	<u>DEPTH</u>
Sand	200
Clay	255
Red Bed	573
Anhydrate lime	589
Red bed	730
Black Shale	890
Shale & shells	1140
Salt	1300
Shale	1380
Lime	1480
Lime & shale	1880
Lime	1940
Lime & shale	2940
Lime	3000
Lime & shale	3165
Lime	3377

RECEIVED
 Conservation-Div.
 SEP 7 X 1949
 STATE CORPORATION
 COMMISSION
 KANSAS

I hereby certify that the above is a true and correct log of said well as reflected by the daily drilling reports.

C. E. Ash

 C. E. Ash

State of Kansas
 County of Sedgwick
 Subscribed and sworn to before me this 9th day of June, 1949.

Mary Humples

 Notary Public

My commission expires ^{Nov.} ~~April~~ 2, 1950.

PLUGGING
 FILE SEC-32T-20R-116
 BOOK PAGE 10 JUNE 31