


Give All Information Completely  
Make Required Affidavit  
Mail or Deliver Report to:  
Conservation Division  
State Corporation Commission  
800 Bittling Building  
Wichita, Kansas

WELL PLUGGING RECORD

NORTH

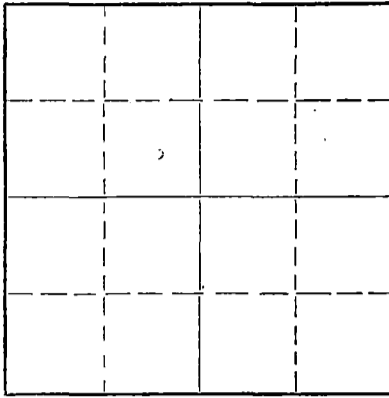

Locate well correctly on above  
Section Plat

Barton County, Sec. 32 Twp 20S Rge. (E) 11 (W)

Location as "NE/CNW%SW%" or footage from lines 10' E of C NW NW SW

Lease Owner The Bay Petroleum Corporation

Lease Name Kowalsky Well No. 1

Office Address Box 513 Chase Kansas

Character of Well (completed as Oil, Gas or Dry Hole) Oil Well

Date well completed September 29 1947

Application for plugging filed (written) October 9 1952

Application for plugging approved (oral) Sept. 29 1952

Plugging commenced Sept. 29 1952

Plugging completed October 3 1952

Reason for abandonment of well or producing formation Failure to produce in commercial quantity

If a producing well is abandoned, date of last production March 1952

Was permission obtained from the Conservation Division or its agents before plugging was commenced? Yes

Name of Conservation Agent who supervised plugging of this well Mr. C.D. Stough

Producing formation Arbuckle Depth to top 3364 Bottom 3373 Total Depth of Well 3373 Feet

Show depth and thickness of all water, oil and gas formations. 3145' PB

OIL, GAS OR WATER RECORDS

CASING RECORD

FORMATION	CONTENT	FROM	TO	SIZE	PUT IN	PULLED OUT
				8 5/8"	558'	None
				5 1/2"	3390'	2762'

Describe in detail the manner in which the well was plugged, indicating where the mud fluid was placed and the method or methods used in introducing it into the hole. If cement or other plugs were used, state the character of same and depth placed, from \_\_\_\_\_ feet to \_\_\_\_\_ feet for each plug set.

Rocked hole from 3145' to 3100' and ran  
5 sacks cement. Mudded hole to 310',  
set rock bridge and ran 20 sacks cement.  
Mudded hole to 35' and ran 10  
sacks of cement to base of cellar.

(If additional description is necessary, use BACK of this sheet)

Name of Plugging Contractor West Supply Co.,  
Address Chase Kansas

STATE OF Kansas, COUNTY OF Rice, ss.  
Forrest Crawford (employee of owner) or (owner or operator) of the above-described

well, being first duly sworn on oath, says: That I have knowledge of the facts, statements, and matters herein contained and the log of the above-described well as filed and that the same are true and correct. So help me God.


(Signature) Forrest Crawford

(Address)

SUBSCRIBED AND SWORN TO before me this 9 day of October, 1952

My commission expires May 20 1954

24-2675-S 2-52-20M

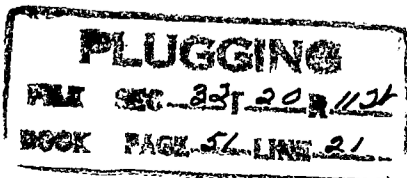

CONSERVATION DIVISION  
Wichita, Kansas

OCT 11 1952

10-11-1952

15.009.14791.0000

LOG BUREAU - KANSAS GEOLOGICAL SOCIETY  
412 Union National Bk. Bldg., Wichita, Kansas

*Chase*


Company - BAY PETROLEUM CORPORATION ET AL  
Farm - Kowalsky No. 1A

SEC. 32 T. 20 R. 11W  
NW 1/4 SW

(Second Hole)

Total Depth. 3373' DF  
Comm. 9-9-47 Comp. 10-7-47  
Shot or Treated.  
Contractor. H H & B Drilling Co., Inc.  
Issued. 11-14-47

County. Barton  
KANSAS

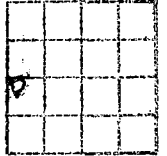

Elevation. \_\_\_\_\_

Production. Pot. 458 BO

CASING:

8-5/8" 560'  
5-1/2" 3360'

Figures Indicate Bottom of Formations.

surface	0-110
sand & shale	200
red bed & shale	560
shale & shells	1130
salt	1378
shale & salt	1450
shale & shells	1520
lime & shale	3100
shale	3130
lime	3171
lime & shale	3190
lime	3311
lime & shale	3371
Arbuckle lime	3377
3377 = 3373 DF	
Total Depth	3373 DF

Tops: KB	
Anhydrite	
Limo Brown	3103
Lansing	3119 DF
Simpson	3363
Arbuckle	3369

Testing Information:  
DST 3161-69, Open 30", rec. 30" mud BHP 650#-10"  
DST 3250-58, Open 30", rec. 30" mud BHP 1000#-10"

Potential:  
State Physical 458 BOPD  
42" stroke, 29 SPM, 1-3/4" pump.

Kowalsky Well #1  
(First Hole)

Rig skidded to 10' east of above location,  
after having lost surface pipe in hole.

T. D. - 2360'  
Comm. - 9-2-47  
Comp. - 9-8-47  
Casing:  
8-5/8" 301' Cem. w/150 sx

clay & sand	0-40
sand & shale	245
red bed & shale	322
red bed & sand	700
red bed & shale	720
anhydrite	750
shale & shells	1130
salt	1376
shale & salt	1560
shale & shells	1785
lime & shale	2360
Total Depth	

Top of Anhydrite 556

RECEIVED

PLUGGING  
FILE SEC. 32 T. 20 R. 11W  
BOOK PAGE 51 LINE 21