


WELL PLUGGING RECORD

Give All Information Completely  
Make Required Affidavit  
Mail or Deliver Report to:  
Conservation Division  
State Corporation Commission  
800 Bitting Building  
Wichita, Kansas

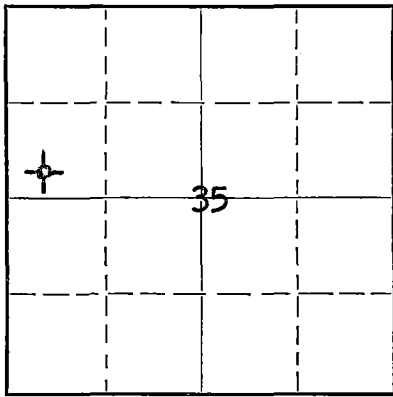

Locate well correctly on above Section Flat

..... Barton ..... County. Sec. 35 Twp. 20 Rge. 11 (E) W. (W)  
Location as "NE/CNW $\frac{1}{4}$ SW $\frac{1}{4}$ " or footage from lines ..... SW SW NW  
Lease Owner ..... Alpine Oil & Royalty Co., Inc.  
Lease Name ..... 300 Bitting Bldg., Wichita, Kansas  
~~Office Address~~ ..... Ida Keeler No. 1  
Character of Well (completed as Oil, Gas or Dry Hole) ..... Dry Hole  
Date well completed ..... December 7, 1950 ..... 19  
Application for plugging filed ..... December 7th ..... 19 50  
Application for plugging approved ..... December 7th ..... 19 50  
Plugging commenced ..... December 7th ..... 19 50  
Plugging completed ..... December 7th ..... 19 50  
Reason for abandonment of well or producing formation.....

If a producing well is abandoned, date of last production ..... 19  
Was permission obtained from the Conservation Division or its agents before plugging was commenced? ..... Yes

Name of Conservation Agent who supervised plugging of this well ..... C. D. Stough  
Producing formation ..... Conglomerate ..... Depth to top ..... 3320 ..... Bottom ..... 3387 ..... Total Depth of Well ..... 3387 ..... Feet  
Show depth and thickness of all water, oil and gas formations.

OIL, GAS OR WATER RECORDS

CASING RECORD

Formation	Content	From	To	Size	Put In	Pulled Out
				8 5/8"	258'	Cemented

Describe in detail the manner in which the well was plugged, indicating where the mud fluid was placed and the method or methods used in introducing it into the hole. If cement or other plugs were used, state the character of same and depth placed, from ..... feet to ..... feet for each plug set.

Set Plug at 250'. Put in 15 sacks cement. Set another Plug at 30 feet, and put in ten (10) sacks cement.

(If additional description is necessary, use BACK of this sheet)

Correspondence regarding this well should be addressed to ..... ALPINE OIL & ROYALTY CO., INC.  
Address ..... 300 Bitting Building, Wichita 2, Kansas

STATE OF Kansas, COUNTY OF Sedgwick, ss.  
Thomas M. McCaul (employee of owner) or (owner or operator) of the above-described well, being first duly sworn on oath, says: That I have knowledge of the facts, statements and matters herein contained and the log of the above-described well as filed and that the same are true and correct. So help me God

(Signature) Thomas M. McCaul  
300 Bitting Building, Wichita, Kansas  
(Address)

SUBSCRIBED AND SWORN to before me this 7th day of December, 1950.

My commission expires August 8, 1953



Lowell Allen  
Notary Public.

PLUGGING DIVISION  
FILE SEC 35 Twp 20 Rge 11  
BOOK PAGE 49 LINE 3  
12-12-50

WELL LOG

Alpine Oil &amp; Royalty Co., Inc.

Commenced: 11-27-50

Contractor: Midwestern Drillers

Completed: 12-6-50

Ida Keeler No. 1  
SW SW NW Sec. 35-20S-11W  
Barton County, Kansas

Production: D &amp; A

Elevation: 1773 R.B.

## Casing Record:


Set 8 5/8" with 220 sack cement at 258 feet.

(Figures Indicate Bottom of Formations)

<u>FORMATION</u>	<u>DEPTH</u>	<u>FORMATION TOPS</u>	
Sand	150	Heebner	2932 -1159
Sand and Shale	220	Brown Lime	3051 -1278
Red Bed	258	Lansing	3070 -1297
Red Bed and Shale	760	Conglomerate	3320 -1547
Shale	800	Total Depth (Rotary)	3387 -1614
Anhydrite and Shale	1160		D & A
Shale and Shells	1315		
Broken Lime and Shale	1450		
Lime	1535		
Anhydrite Lime & Shale	1705		
Lime and Shale	2460		
Shale and Lime Streaks	2632		
Shale and Lime	3070		
Lime and Shale Streaks	3140		
Lime and Shale	3320		
Conglomerate	3387 T.D.		

I hereby certify that the above is a true and correct copy of Driller's Log of well drilled in the SW SW NW of Section 35, Township 20 South, Range 11 West, Barton County, Kansas.

ALPINE OIL &amp; ROYALTY CO., INC.

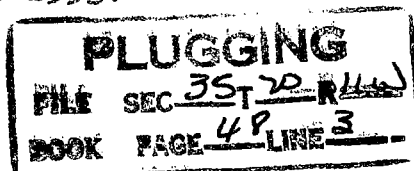By: Thomas M. McCaulSubscribed and sworn to before me this 8th day of December, 1950.Low Ann Allen  
Notary PublicMy commission expires:  
August 8, 1953.

**RECEIVED**  
STATE CORPORATION DIVISION  
DEC 12 1950  
CONSERVATION DIVISION  
Wichita, Kansas