

CARD MUST BE TYPED

State of Kansas  
NOTICE OF INTENTION TO DRILL

CARD MUST BE SIGNED

(see rules on reverse side)

Starting Date: March 23, 1985  
month day year

API Number 15- 097-21,126-0000

OPERATOR: License # 8565

APRC SW SW 1/4

Sec. 34 Twp. 30 S, Rge. 17.  East  West  
(location)

Name Huey P. Grey

Address Rt. 1 Box 47

City/State/Zip Greensburg, Kansas 67054

Contact Person Huey Grey

Phone 316-723-3123

560 Ft North from Southeast Corner of Section  
~~4440~~ Ft West from Southeast Corner of Section  
(Note: Locate well on Section Plat on reverse side)

CONTRACTOR: License # 5380

Name Eagle Drilling, Inc.

City/State Wichita, Kansas 67208

Nearest lease or unit boundary line 480 feet.

County Kiowa

Lease Name Wedel Well# 1

Domestic well within 330 feet:  yes  no

Municipal well within one mile:  yes  no

Well Drilled For: Well Class: Type Equipment:

- Oil  Swd  Infield  Mud Rotary
- Gas  Inj  Pool Ext.  Air Rotary
- OWWO  Expl  Wildcat  Cable

If OWWO: old well info as follows:

Operator

Well Name

Comp Date Old Total Depth

Projected Total Depth 5100 feet

Projected Formation at TD Mississippi

Expected Producing Formations Mississippi

Depth to Bottom of fresh water 225 feet

Lowest usable water formation ~~220~~

Depth to Bottom of usable water 225 feet

Surface pipe by Alternate: 1  2

Surface pipe to be set 750 feet

Conductor pipe if any required none feet

Ground surface elevation 2124 feet MSL

This Authorization Expires 9-21-85

Approved By 3-21-85 H.C.

I certify that we will comply with K.S.A. 55-101, et seq., plus eventually plugging hole to K.C.C. specifications.

Date March 16, 1985 Signature of Operator or Agent

*Huey Grey*


Title Operator

mhc/kone 3-21-85

Must be filed with the K.C.C. five (5) days prior to commencing well  
This card void if drilling not started within six (6) months of date received by K.C.C.

**Important procedures to follow :**

**A Regular Section of Land  
1 Mile = 5,280 Ft.**

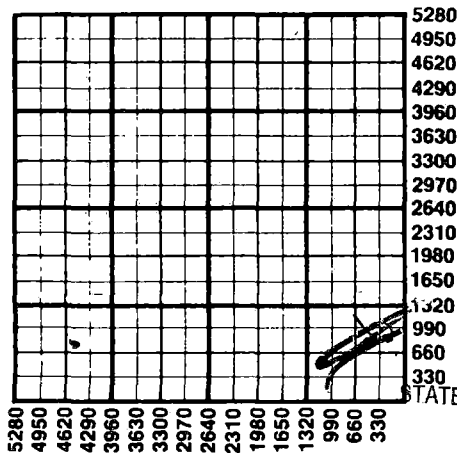

1. Notify District office before setting surface casing.
2. Set surface casing by circulating cement to the top.
3. File completion forms ACO-1 with K.C.C. within 90 days of well completion, following instructions on ACO-1, side 1, and including copies of wireline logs.
4. Notify District office 48 hours prior to old well workover or re-entry.
5. Prior to plugging, prepare a plugging plan, then obtain agreement from the appropriate district office for an approved plugging plan.
6. Submit plugging report (CP-4) to K.C.C. after plugging is completed.
7. Obtain an approved injection docket number before disposing of salt water.
8. Notify K.C.C. within 10 days when injection commences or terminates.

9. If an alternate 2 completion, cement in the production pipe from below any usable water to surface within 120 days of spud date.

RECEIVED

STATE CORPORATION COMMISSION

MAR 21 1985  
3-21-85

CONSERVATION DIVISION  
Wichita, Kansas

State Corporation Commission of Kansas  
Conservation Division  
200 Colorado Derby Building  
Wichita, Kansas 67202  
(316) 263-3238