

CARD MUST BE TYPED

State of Kansas  
NOTICE OF INTENTION TO DRILL

CARD MUST BE SIGNED

(see rules on reverse side)

Starting Date: July 18 1984  
month day year

API Number 15- 097-21,051-0000

OPERATOR: License # 5171

NE SE NW Sec 8 Twp 30 S, Rge 18  East  West  
(location)

Name TXO Production Corp.

Address 200 W. Douglas, Suite 300

City/State/Zip Wichita, KS 67202

Contact Person Gary Wurdeman

Phone 316-265-9441

3630 Ft North from Southeast Corner of Section

2970 Ft West from Southeast Corner of Section

(Note: Locate well on Section Plat on reverse side)

CONTRACTOR: License # 5106

Name Freeman Drilling, Inc.

City/State Wichita, Ks

Nearest lease or unit boundary line 1650 feet.

County Kiowa

Lease Name PARKIN "D" Well# 1

Domestic well within 330 feet:  yes  no

Municipal well within one mile:  yes  no

Well Drilled For: Well Class: Type Equipment:

- Oil  Swd  Infield  Mud Rotary
- Gas  Inj  Pool Ext.  Air Rotary
- OWWO  Expl  Wildcat  Cable

Depth to Bottom of fresh water 100 feet

Lowest usable water formation Unknown

Depth to Bottom of usable water 200 feet

Surface pipe by Alternate:  2

Surface pipe to be set 450 feet

Conductor pipe if any required 0 feet

Ground surface elevation TBD feet MSL

If OWWO: old well info as follows:

Operator

Well Name

Comp Date Old Total Depth

Projected Total Depth 5100 feet

Projected Formation at TD Miss

Expected Producing Formations Miss

This Authorization Expires

Approved By RCH/KCC 7-18-84

I certify that we will comply with K.S.A. 55-101, et seq., plus eventually plugging hole to K.C.C. specifications.

Date July 13, 1984 Signature of Operator or Agent

*[Handwritten Signature]*

Title District Engineer

*[Handwritten Signature]* Form C-1 4/84

THIS PERMIT  
EXPIRES  
JAN 4 8 1985

Must be filed with the K.C.C. five (5) days prior to commencing well  
This card void if drilling not started within six (6) months of date received by K.C.C.


RECEIVED  
STATE CORPORATION COMMISSION

Important procedures to follow: JUL 18 1984

CONSERVATION DIVISION  
Wichita, Kansas

7-18-84

**A Regular Section of Land**  
1 Mile = 5,280 Ft.

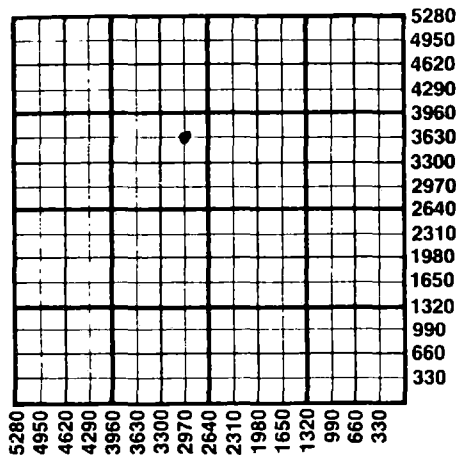

1. Notify District office before setting surface casing.
2. Set surface casing by circulating cement to the top.
3. File completion forms ACO-1 with K.C.C. within 90 days of well completion, following instructions on ACO-1, side 1, and including copies of wireline logs.
4. Notify District office 48 hours prior to old well workover or re-entry.
5. Prior to plugging, prepare a plugging plan, then obtain agreement from the appropriate district office for an approved plugging plan.
6. Submit plugging report (CP-4) to K.C.C. after plugging is completed.
7. Obtain an approved injection docket number before disposing of salt water.
8. Notify K.C.C. within 10 days when injection commences or terminates.
9. If an alternate 2 completion, cement in the production pipe from below any usable water to surface within 120 days of spud date.

State Corporation Commission of Kansas  
Conservation Division  
200 Colorado Derby Building  
Wichita, Kansas 67202  
(316) 263-3238