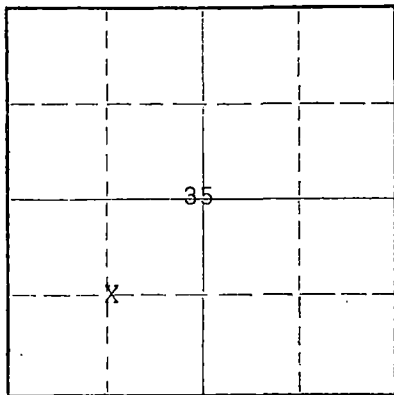


Give All Information Completely
Make Required Affidavit
Mail or Deliver Report to:
Conservation Division
State Corporation Commission
211 No. Broadway
Wichita, Kansas

WELL PLUGGING RECORD

NORTH

Locate well correctly on above
Section Plat

Stanton County, Sec. 35 Twp. 30S Rge. 42W (X) (W)
Location as "NE/CNW&SW" or footage from lines C SW/4
Lease Owner Superior Oil Co.
Lease Name Weaver Well No. Unit #2
Office Address Box 200, Casper, Wyoming
Character of Well (completed as Oil, Gas or Dry Hole) Dry Hole
Date well completed 19____
Application for plugging filed March 16 19 64
Application for plugging approved March 16 19 64
Plugging commenced March 24 19 64
Plugging completed March 28 19 64
Reason for abandonment of well or producing formation Dry Hole

If a producing well is abandoned, date of last production 19____
Was permission obtained from the Conservation Division or its agents before plugging was commenced? Yes

Name of Conservation Agent who supervised plugging of this well Hugh Scott
Producing formation Keyes Depth to top 5205' Bottom 5258' Total Depth of Well 5258' Feet
Show depth and thickness of all water, oil and gas formations.

OIL, GAS OR WATER RECORDS

CASING RECORD

FORMATION	CONTENT	FROM	TO	SIZE	PUT IN	PULLED OUT
Morrow Keyes	Water	5258	5216	4-1/2	5258'	2513'

Describe in detail the manner in which the well was plugged, indicating where the mud fluid was placed and the method or methods used in introducing it into the hole. If cement or other plugs were used, state the character of same and depth placed, from _____ feet to _____ feet for each plug set.

Filled 4-1/2" csg. w/water. Dumped in sand from 5236-5200 & put 5 sx cmt. plug from 5200-5140 w/dump bailer. Pulled 2513' of 4-1/2" csg. Mixed & pumped 19 bbls. very viscous mud followed by rubber plug and 50 sx. reg. cmt. w/2% CaCl₂ followed by another rubber plug & displaced to 1380'. Plug interval 1560' to 1380'. Installed 8-5/8" to 2" swage & 2" valve @ surface. Will retain 8-5/8" surface scg. for future water disposal.

RECEIVED
STATE CORPORATION COMMISSION

APR 7 1964

CONSERVATION DIVISION
Wichita, Kansas

4-7-1964

(If additional description is necessary, use BACK of this sheet)

Name of Plugging Contractor Forbes Casing Pullers
Address Great Bend, Kansas

STATE OF Wyoming, COUNTY OF Natrona, ss.

J. P. Dujka (employee of owner) or ~~XXXXXX~~ of the above-described well, being first duly sworn on oath, says: That I have knowledge of the facts, statements, and matters herein contained and the log of the above-described well as filed and that the same are true and correct. So help me God.

(Signature)

J. P. Dujka

P. O. Box 200, Casper, Wyoming
(Address)

SUBSCRIBED AND SWORN TO before me this 6th day of April, 1964

My commission expires Sep. 5, 1965

Notary Public.

