


STATE OF KANSAS
STATE CORPORATION COMMISSION

Give All Information Completely
Make Required Affidavit
Mail or Deliver Report to:
Conservation Division
State Corporation Commission
211 No. Broadway
Wichita, Kansas

WELL PLUGGING RECORD

NORTH

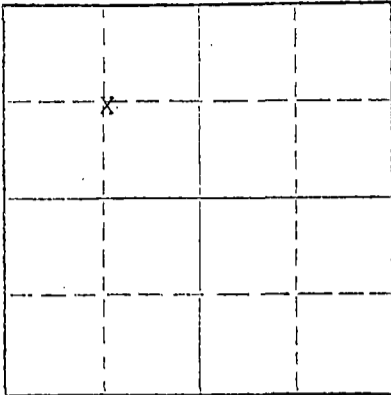

Locate well correctly on above
Section Plat

Stanton County, Sec. 35 Twp. 30S Rge. (E)42 (W)
Location as "NE/CNW/SE/SW" or footage from lines C NW 1/4
Lease Owner The Superior Oil Co.
Lease Name Weaver Well No. 1
Office Address Box 553, Alva, Oklahoma 73717
Character of Well (completed as Oil, Gas or Dry Hole) Gas
Date well completed September 2, 19 55
Application for plugging filed December 20 19 67
Application for plugging approved December 22 19 67
Plugging commenced February 5 19 68
Plugging completed February 8 19 68
Reason for abandonment of well or producing formation Well depleted

If a producing well is abandoned, date of last production December 7 19 67
Was permission obtained from the Conservation Division or its agents before plugging was commenced? Yes

Name of Conservation Agent who supervised plugging of this well Mr. Eves
Producing formation Morrow (Gas) Depth to top 5137 Bottom 5301 Total Depth of Well 5335 Feet
Show depth and thickness of all water, oil and gas formations.

OIL, GAS OR WATER RECORDS

CASING RECORD

FORMATION	CONTENT	FROM	TO	SIZE	PUT IN	PULLED OUT
Morrow	Gas	5203	5252	10-3/4"	1518'	0
				7"	5335'	2834.63'

Describe in detail the manner in which the well was plugged, indicating where the mud fluid was placed and the method or methods used in introducing it into the hole. If cement or other plugs were used, state the character of same and depth placed, from _____ feet to _____ feet for each plug set.

Mix 25 sks. cement and 1 sk. hulls to plug off perfs. Top of cement at 4,762'.
50 sks. cement at 800' to 700'.
Mud to 35'
15 sks. cement at 35' to 0'
Use 5 sks. gell
Pulled 2,834.63' of 7"

RECEIVED
STATE CORPORATION COMMISSION
FEB 23 1968
CONSERVATION DIVISION
Wichita, Kansas
2-23-1968

(If additional description is necessary, use BACK of this sheet)

Name of Plugging Contractor Sargent Casing Pullers
Address Box 506, Liberal, Kansas 67901

STATE OF Wyoming, COUNTY OF Natrona, ss.
Herman High

(employee of owner) or (owner or operator) of the above-described well, being first duly sworn on oath, says: That I have knowledge of the facts, statements, and matters herein contained and the log of the above-described well as filed and that the same are true and correct. So help me God.

(Signature) Herman High

P. O. Box 200, Casper, Wyoming 82601
(Address)

SUBSCRIBED AND SWORN TO before me this 21st day of February, 19 68

My commission expires September 13, 1969

J. R. Voris

Notary Public.