


Give All Information Completely  
Make Required Affidavit  
Mail or Deliver Report to:  
Conservation Division  
State Corporation Commission  
211 No. Broadway  
Wichita, Kansas

WELL PLUGGING RECORD

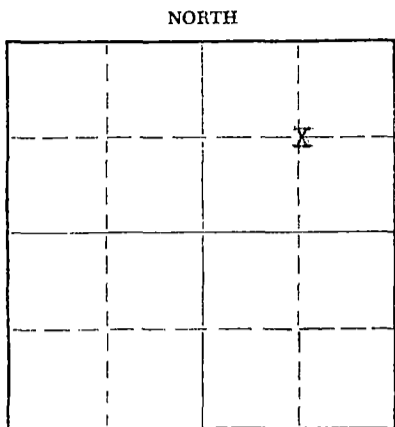

Stanton County. Sec. 34 Twp 30 S. Rge. 42 (E) (W)  
Location as "NE/CNW&SW&" or footage from lines C- NE/4  
Lease Owner J. M. Huber Corporation  
Lease Name Sparks Well No. 1  
Office Address Box 978, Liberal, Kansas  
Character of Well (completed as Oil, Gas or Dry Hole) Gas  
Date well completed July 16 19 54  
Application for plugging filed March 2 19 67  
Application for plugging approved March 7 19 67  
Plugging commenced 3 - 11 19 67  
Plugging completed 3 - 14 19 67  
Reason for abandonment of well or producing formation Depleted

If a producing well is abandoned, date of last production December 19 66  
Was permission obtained from the Conservation Division or its agents before plugging was commenced? Yes

Name of Conservation Agent who supervised plugging of this well Ed Eves  
Producing formation Keyes Depth to top 5254 Bottom 5262 Total Depth of Well 5554 Feet  
Show depth and thickness of all water, oil and gas formations.

OIL, GAS OR WATER RECORDS

CASING RECORD

FORMATION	CONTENT	FROM	TO	SIZE	PUT IN	PULLED OUT
Keyes	Gas	5254	5262	8 5/8	1525	0
				5 1/2	5375	3006

Describe in detail the manner in which the well was plugged, indicating where the mud fluid was placed and the method or methods used in introducing it into the hole. If cement or other plugs were used, state the character of same and depth placed, from \_\_\_\_\_ feet to \_\_\_\_\_ feet for each plug set.

Mix 20 sacks cement and 1 sack hulls to plug off perforrations at 5254. Stop plug at 5150 feet. Shoot pipe loose at 3006 and lay down same to 700 feet. Pump 40 sacks cement at 700 to 600 feet. Lay down all casing and fill hole with mud to 35 feet and bridge and 10 sacks cement at 35 feet to 0. Cut off 8 5/8 3 feet below ground level. Complete plugging 3-14-67.

RECEIVED  
CONSERVATION COMMISSION  
MAR 29 1967  
3-29-1967  
CONSERVATION DIVISION  
Wichita, Kansas

(If additional description is necessary, use BACK of this sheet)  
Name of Plugging Contractor Sargent's Casing Pulling Service  
Address Box 506 Liberal, Kansas

STATE OF Kansas, COUNTY OF Seward, ss.  
Harold Jones (employee of owner) or (owner or operator) of the above-described well, being first duly sworn on oath, says: That I have knowledge of the facts, statements, and matters herein contained and the log of the above-described well as filed and that the same are true and correct. So help me God.

(Signature) Harold Jones  
Box 978, Liberal, Kansas  
(Address)

SUBSCRIBED AND SWORN TO before me this 28 day of March, 1967.  
Frank R. Stahlkefeldt  
Notary Public.

My commission expires May 26, 1968

DRILLER'S LOG

COMPANY: J. A. HUBER CORPORATION LOCATION: C NE Sec. 34-30S-42W,  
 CONTRACTOR: BIG CHIEF DRILLING COMPANY Stanton County, Kansas

FARM NAME: Sparks No. 1 PRODUCTION: Gas well

COMMENCED: June 7, 1954 ELEVATION: 3508 derrick floor  
 COMPLETED: July 10, 1954

CASING USED: 8 5/8" at 1525 with 710 sacks Pozmix  
 5 1/2" at 5375 with 200 sacks Pozmix

	<u>FROM</u>	<u>TO</u>	<u>TOPS</u>
Sand and shale	0	820	Wabaunsee 2912
Shale and Anhydrite	820	1165	Topeka 3132
Shale and shells	1165	1310	Lansing 3442
Shale and Anhydrite	1310	1500	Marmaton 4120
Anhydrite	1500	1530	Cherokee 4044
Shale and shells	1530	2160	Morrow Shale 4902
Lime	2160	2167	Morrow Lime 5178
Shale and lime	2167	2335	Morrow Sand 5254
Lime	2335	2370	Mississippi (St. Gen.) 5343
Shale and lime	2370	2450	St. Louis 5470
Lime	2450	2475	
Shaly lime and lime	2475	2585	
Lime	2585	2600	<u>CORES</u>
Shale	2600	2625	Core 5275-5324, recovered 49'
Lime	2625	2650	5275-5323 Gray fine to coarse grained,
Shale	2650	2678	glauconitic, slightly
Lime	2678	2700	shaly porous sand.
Shale	2700	2754	5323-5324 Basal conglomeratic sand,
Broken Lime	2754	2790	with coarse black shale
Shale	2790	2855	pebbles.
Lime	2855	2870	
Broken Lime	2870	3003	
Lime	3003	3090	
Shale	3090	3132	
Lime	3132	3197	
Lime and shale	3197	3288	
Lime	3288	3355	
Shaly lime	3355	3380	
Lime	3380	3408	
Broken lime	3408	3442	
Lime	3442	3557	
Black shale	3557	3563	
Lime	3563	3571	
Shale	3571	3588	
Lime	3588	3608	
Broken lime	3608	3700	
Lime	3700	3745	
Broken lime	3745	3820	
Lime	3820	3840	
Shale	3840	3880	
Lime	3880	3930	
Limy shale	3930	3989	
Lime	3989	4010	
Shale	4010	4030	
Lime	4030	4050	
Shale	4050	4120	
Lime	4120	4152	
Lime and shale	4152	4205	
Lime and limy shale	4205	4400	
Shale	4400	4460	
Lime	4460	4470	

Driller's Log (No. 1 Sparks) continued

Shale	4470	4510
Lime	4510	4540
Shale	4540	4580
Lime	4580	4600
Shale	4600	4620
Lime	4620	4640
Lime and shale	4640	4670
Lime	4670	4720
Lime and shale	4720	4900
Black shale	4900	5178
Sandy lime	5178	5210
Sandy lime and shale	5210	5254
Gray sand	5254	5341
Red sand	5341	5360
Sandy lime	5360	5470
Lime	5470	5554

RECEIVED  
 STATE GEOLOGICAL COMMISSION  
 MAR 7 1967  
 COMMISSION DIVISION  
 WICHITA, KANSAS

I hereby certify the foregoing to be a true and accurate Driller's Log of the formations encountered in the above well.

J. M. HUBER CORPORATION

By Richard C. Strohmeier  
 Richard C. Strohmeier, Geologist

Subscribed and sworn to before me this 16th day of September, 1954.

Sarah J. Reeves  
 Notary Public  
 Sedgwick County, Kansas

My commission expires:

January 26, 1957