


STATE OF KANSAS
STATE CORPORATION COMMISSION

Give All Information Completely
Make Required Affidavit
Mail or Deliver Report to:
Conservation Division
State Corporation Commission
211 No. Broadway
Wichita, Kansas

WELL PLUGGING RECORD

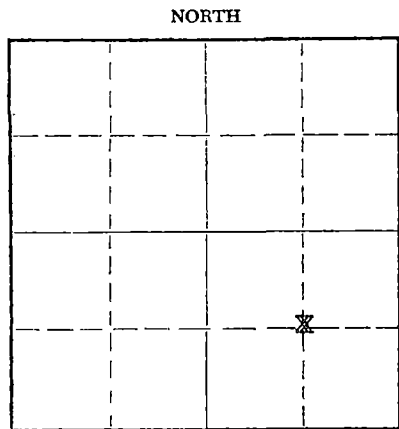

Locate well correctly on above
Section Plat

Stanton County, Sec. 34 Twp. 30S Rge. (E) 42 (W)
Location as "NE/CNW/SW" or footage from lines 1320' FSL & 1320' FEL
Lease Owner The Superior Oil Company
Lease Name Royalty Holders Corp. Unit Well No. 2
Office Address P. O. Box 200, Casper, Wyoming 82601
Character of Well (completed as Oil, Gas or Dry Hole) Dry Hole
Date well completed July 31 19 68
Application for plugging filed July 26 19 68
Application for plugging approved 19
Plugging commenced July 29 19 68
Plugging completed July 31 19 68
Reason for abandonment of well or producing formation Dry

If a producing well is abandoned, date of last production ----- 19
Was permission obtained from the Conservation Division or its agents before plugging was commenced? Yes

Name of Conservation Agent who supervised plugging of this well Mr. Eves
Producing formation Morrow Keyes Depth to top 5227 Bottom 5268 Total Depth of Well 5268 Feet
Show depth and thickness of all water, oil and gas formations.

OIL, GAS OR WATER RECORDS

CASING RECORD

FORMATION	CONTENT	FROM	TO	SIZE	PUT IN	PULLED OUT
Morrow Keyes	Gas & Water	5227	5268	8-5/8"	1511'	0
Morrow "G"	Gas	5202	5227	5-1/2"	5229'	3034'

Describe in detail the manner in which the well was plugged, indicating where the mud fluid was placed and the method or methods used in introducing it into the hole. If cement or other plugs were used, state the character of same and depth placed, from _____ feet to _____ feet for each plug set.

Dumped 10 sack plug across perforations (5208-5218') with bailer. Plug placed from 5244' to 5144'. Shot off and recovered 3034' of 5-1/2" casing. Pulled casing to 750'. Spotted 35 sack cement plug from 750' up to 645'. Finished pulling out of hole with casing. Pumped in mud from 645' up to 30'. Placed 10 sack cement plug in top of surface pipe. Cut off surface pipe 36" below ground level. Welded on plate.

RECEIVED
STATE CORPORATION COMMISSION

AUG 12 1968

CONSERVATION DIVISION
Wichita, Kansas

8-12-1968

(If additional description is necessary, use BACK of this sheet)
Name of Plugging Contractor Santa Fe Pipe & Supply Company
Address Box 562, Great Bend, Kansas

STATE OF WYOMING, COUNTY OF NATRONA, ss.
Herman High (employee of owner) or (owner or operator) of the above-described well, being first duly sworn on oath, says: That I have knowledge of the facts, statements, and matters herein contained and the log of the above-described well as filed and that the same are true and correct. So help me God.

(Signature) Herman High
P. O. Box 200, Casper, Wyoming 82601
(Address)

SUBSCRIBED AND SWORN to before me this 9th day of August, 19 68

My commission expires August 21, 1971
Jeannette H. Parke Notary Public

