

15.187.00025.00.00

STATE OF KANSAS  
STATE CORPORATION COMMISSION


WELL PLUGGING RECORD

Give All Information Completely  
Make Required Affidavit  
Mail or Deliver Report to:  
Conservation Division  
State Corporation Commission  
211 No. Broadway  
Wichita, Kansas

Stanton County, Sec. 33 Twp. 30S Rge. (E) 42 (W)

Location as "NE/CNW&SW" or footage from lines 3960' FSL & 3960' FWL  
Lease Owner The Superior Oil Company  
Lease Name Royalty Holders Corp. Unit Well No. 1  
Office Address P. O. Box 200, Casper, Wyoming 82601  
Character of Well (completed as Oil, Gas or Dry Hole) Gas  
Date well completed July 2 1955  
Application for plugging filed July 26 1968  
Application for plugging approved 19  
Plugging commenced August 5 1968  
Plugging completed August 12 1968  
Reason for abandonment of well or producing formation Well Depleted

NORTH

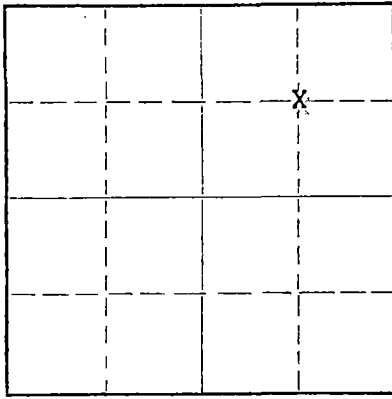

Locate well correctly on above  
Section Plat

If a producing well is abandoned, date of last production June 4 1968  
Was permission obtained from the Conservation Division or its agents before plugging was commenced? Yes

Name of Conservation Agent who supervised plugging of this well Mr. Eves & Mr. Granvill  
Producing formation Morrow Keyes Depth to top 5247 Bottom 5329 Total Depth of Well 5356 Feet  
Show depth and thickness of all water, oil and gas formations.

OIL, GAS OR WATER RECORDS

CASING RECORD

FORMATION	CONTENT	FROM	TO	SIZE	PUT IN	PULLED OUT
Morrow Keyes	Gas	5247	5329	10-3/4"	1527'	0
				7"	5352'	2328

Describe in detail the manner in which the well was plugged, indicating where the mud fluid was placed and the method or methods used in introducing it into the hole. If cement or other plugs were used, state the character of same and depth placed, from \_\_\_\_\_ feet to \_\_\_\_\_ feet for each plug set.

Spotted 25 sacks cement across perforations (5252-5262') from 5262' up to 5000. Shot and recovered 2328' - 7" casing. Pulled casing to 1000'. Mixed 5 sacks gel and pumped in hole. Pulled casing to 900'. Spotted 50 sack cement plug from 900' up to 750'. Finished out of hole with casing. Filled hole with mud from 750' up to 30'. Placed 10 sack cement plug in top of surface. Cut off casing 36" below ground level. Welded on plate.

RECEIVED  
STATE CORPORATION COMMISSION

AUG 15 1968

CONSERVATION DIVISION  
Wichita, Kansas

8-15-1968

(If additional description is necessary, use BACK of this sheet)  
Name of Plugging Contractor Sargent Casing Pullers  
Address Box 506, Liberal, Kansas

STATE OF WYOMING, COUNTY OF NATRONA, ss.  
Herman High (employee of owner) or (owner or operator) of the above-described well, being first duly sworn on oath, says: That I have knowledge of the facts, statements, and matters herein contained and the log of the above-described well as filed and that the same are true and correct. So help me God.

(Signature) Herman High  
P. O. Box 200, Casper, Wyoming 82601  
(Address)

SUBSCRIBED AND SWORN TO before me this 14th day of August, 1968

Jeannette H. Parke  
Jeannette H. Parke  
Notary Public.

My commission expires August 21, 1971



15.187.00025.00.00

COPY


WELL LOG BUREAU—KANSAS GEOLOGICAL SOCIETY  
508 East Murdock, Wichita, Kansas

Company- SUPERIOR OIL COMPANY  
Farm- RHC Unit No. 1

SEC. 33 T. 30 R. 42W  
C NE½

Total Depth. 5356  
Comm. 6-8-55 Comp. 7-15-55  
Shot or Treated:  
Contractor.  
Issued. 8-25-56

County Stanton  
KANSAS

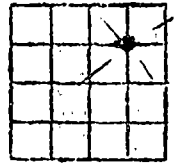

CASING:  
16" 1525'  
7" 5352'

Elevation. 3544 RB

Production. 9,400,000 gas

Figures indicate Bottom of Formations.

red beds	55
sand	175
shale sdy	430
shale	914
red beds, shale, anhyd.	1498
anhydrite	1637
anhydrite, shale	1937
shale	2177
shale, shells	2352
shale	2421
shale, lime	3074
lime	3815
lime, shale	3888
lime	4109
lime, shale	4417
lime	4525
lime, shale	4607
lime	4714
lime, shale	4979
shale	5030
shale, lime	5190
sand	5280
sand, shale	5318
sand	5356
Total Depth	

Tops: Scout	
Topkea	3255
Heebner	3570
Kansas City	3645
Morrow shale	4915
Morrow sand	5165
Miss.	5322

RECEIVED  
STATE CORPORATION COMMISSION  
AUG 22 1968  
CONSERVATION DIVISION  
Wichita, Kansas