


15.187.00027.00.00

STATE OF KANSAS
STATE CORPORATION COMMISSION

Give All Information Completely
Make Required Affidavit
Mail or Deliver Report to:
Conservation Division
State Corporation Commission
211 No. Broadway
Wichita, Kansas

WELL PLUGGING RECORD

NORTH

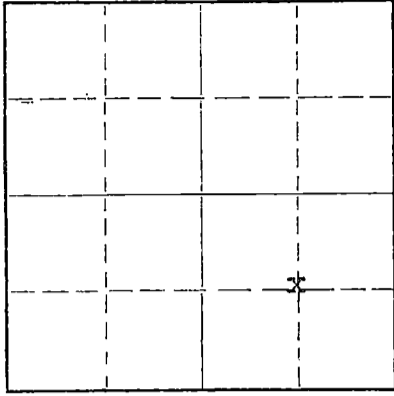

Locate well correctly on above
Section Plat

Stanton County. Sec. 32 Twp. 30S. Rge. (E) 42 (W)
Location as "NE/CNW4SW4" or footage from lines C - SE/4
Lease Owner United Producing Company, Inc.
Lease Name U. S. Hague Well No. 1
Office Address Drawer 30, Liberal, Kansas
Character of Well (completed as Oil, Gas or Dry Hole) Dry Hole
Date well completed 9-7 19 55
Application for plugging filed 10-31 19 55
Application for plugging approved 11-1 19 55
Plugging commenced 5-9 19 56
Plugging completed 5-9 19 56
Reason for abandonment of well or producing formation Dry Hole

If a producing well is abandoned, date of last production 19
Was permission obtained from the Conservation Division or its agents before plugging was commenced? Yes

Name of Conservation Agent who supervised plugging of this well Mr. M. A. Rives
Producing formation Depth to top Bottom Total Depth of Well 5449 Feet
Show depth and thickness of all water, oil and gas formations.

OIL, GAS OR WATER RECORDS

CASING RECORD

FORMATION	CONTENT	FROM	TO	SIZE	PUT IN	PULLED OUT
Sand and shale	fresh water	0	600	8 5/8	1546	none

Describe in detail the manner in which the well was plugged, indicating where the mud fluid was placed and the method or methods used in introducing it into the hole. If cement or other plugs were used, state the character of same and depth placed, from feet to feet for each plug set.

Plugging Data - Hole filled with mud. Halliburton set plug with 18 sacks @ 600'.
Mudded up to 45' of surface cemented with 27 sacks.

STATE OF KANSAS
MAY 1956
CONSERVATION DIVISION
Wichita, Kansas
5-18-1956

(If additional description is necessary, use BACK of this sheet)
Name of Plugging Contractor Company
Address Drawer 30, Liberal, Kansas

STATE OF Kansas, COUNTY OF Seward, ss.
A. H. Pannell (employee of owner) or (owner or operator) of the above-described well, being first duly sworn on oath, says: That I have knowledge of the facts, statements, and matters herein contained and the log of the above-described well as filed and that the same are true and correct. So help me God.

(Signature) A. H. Pannell Production Supt.
Drawer 30, Liberal, Kansas (Address)

SUBSCRIBED AND SWORN TO before me this 16th day of May, 1956

C. J. DAVIS
Notary Public
Notary Public.

My commission expires 8-31-59

PLUGGING
FILE SEC 32 T 30 R 42W
BOOK PAGE 24 LINE 12

MAY 1956
CONSERVATION DIVISION
Wichita, Kansas