


STATE OF KANSAS
STATE CORPORATION COMMISSION

WELL PLUGGING RECORD

Give All Information Completely
Make Required Affidavit
Mail or Deliver Report to
Conservation Division
State Corporation Comm.
245 North Water
Wichita, KS 67202

Stanton County, Sec. 28 Twp. 30S Rge. 12W E/W
Location as "NE/CNW $\frac{1}{4}$ SW $\frac{1}{4}$ " or footage from lines
1890' FNL & 1250' FWL
Lease Owner Texas Oil & Gas Corp.
Lease Name Weaver "C" Well No. 1
Office Address 200 W. Douglas Suite 300 Wichita, Ks. 67202
Character of Well (Completed as Oil, Gas or Dry Hole) _____

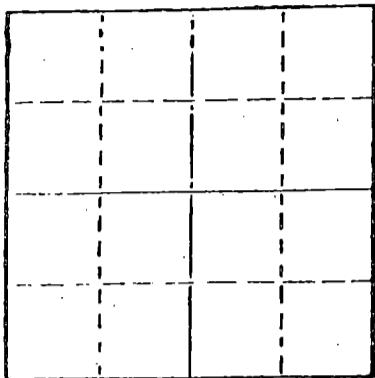

Locate well correctly on above
Section Plat

Gas
Date Well completed _____ 19____
Application for plugging filed August 23 1978
Application for plugging approved August 25 1978
Plugging commenced Sept. 1 1978
Plugging completed Sept. 5 1978
Reason for abandonment of well or producing formation _____

If a producing well is abandoned, date of last production _____ 19____

Was permission obtained from the Conservation Division or its agents before plugging was commenced? Yes

Name of Conservation Agent who supervised plugging of this well Clarence Thomas
Producing formation _____ Depth to top _____ Bottom _____ Total Depth of Well 5362
Show depth and thickness of all water, oil and gas formations.

OIL, GAS OR WATER RECORDS

CASING RECORD

FORMATION	CONTENT	FROM	TO	SIZE	PUT IN	PULLED OUT
				8 5/8	1497	none
				4 1/2	5361	3025

Describe in detail the manner in which the well was plugged, indicating where the mud fluid was placed and the method or methods used in introducing it into the hold. If cement or other plugs were used, state the character of same and depth placed, from _____ feet to _____ feet for each plug set.

Pump 20 sks. of cement from 5240' to 5000'
Pump 35 sks. of cement from 1400' to 1300'
Put 10 sks. of cement from 40 to 0

RECEIVED
STATE CORPORATION COMMISSION

SEP 27 1978

CONSERVATION DIVISION
Wichita, Kansas

9-27-1978

(If additional description is necessary, use BACK of this sheet)

Name of Plugging Contractor Sargent's Casing Pulling Ser. Box 506 Liberal, Kansas 67901

STATE OF Kansas COUNTY OF Sedgwick, ss.

STEPHEN G. TILLMAN of Texas Oil & Gas Corp. (employee of owner) or (owner or operator) of the above-described well, being first duly sworn on oath, says: That I have knowledge of the facts, statements, and matters herein contained and the log of the above-described well as filed and that the same are true and correct. So help me God.


(Signature) Stephen G. Tillman

STEPHEN G. TILLMAN, Texas Oil & Gas Corp.
200 W. Douglas, (Address) Suite 300, Wichita, KS
67202

SUBSCRIBED AND SWORN TO before me this 26th day of September, 1978

Elizabeth A. Cauley
Elizabeth A. Cauley Notary Public.

My commission expires January 23, 1980

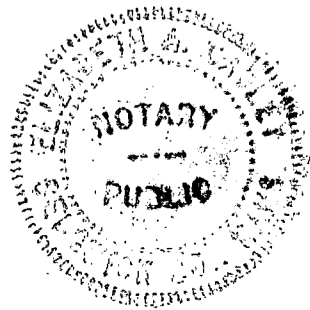

DRILLER'S LOG

COMPANY: Texas Oil & Gas Corp.

SEC. 28 T. 30S R. 42W

WELL NAME: Weaver "C" #1

LOC. 1890' FNL & 1250' FWL

COUNTY: Stanton

RIG NO. #2

TOTAL DEPTH 5362'

ELEVATION

COMMENCED: 5-13-78

COMPLETED: 6-1-78

CONTRACTOR: Rains & Williamson Oil Co., Inc.

CASING RECORD:

SURFACE: 8 5/8" @ 1497' w/500 sx. 65/35 poz., 6% gel. and 150 sx. Class H, 2% gel., 2% cc.

PRODUCTION: 4 1/2" @ 5361' w/125 sx. 50/50 poz., 8# gilsonite per sack, 18% salt, 2% gel. and 1/25th CFR2.

LOG

(Figures Indicate Bottom of Formations)

Clay, Sand & Redbed	442
Redbed, Sand & Clay	690
Sand, Redbed & Clay	990
Redbed	1080
Sand & Shale	1510
Shale	1525
Sand & Shale	1738
Shale	2335
Lime & Shale	5362
<u>ROTARY TOTAL DEPTH</u>	<u>5362</u>

RECEIVED
STATE COMMISSIONER OF REVENUE

AUG 24 1978

CONSERVATION
Wichita, Kansas

STATE OF Kansas)

COUNTY OF Sedgwick)


SS:

I, Wilson Rains, President of Rains & Williamson Oil Co., Inc.

upon oath state that the above and foregoing is a true and correct copy of the log of the

Weaver "C" #1 well.

Wilson Rains
Wilson Rains

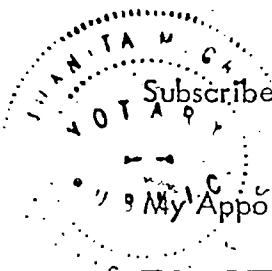

Subscribed and sworn to before me this 5 day of June, 1978.


Juanita M. Green
Juanita M. Green

10.187.20276.00.00

WELL : WEAVER C" #1

LOCATION : 1980' FNL & 1250' FNL SEC 28-305-42W, STANTON Co. KS

ELEVATION : 3547 G.L. 3556 K.B.

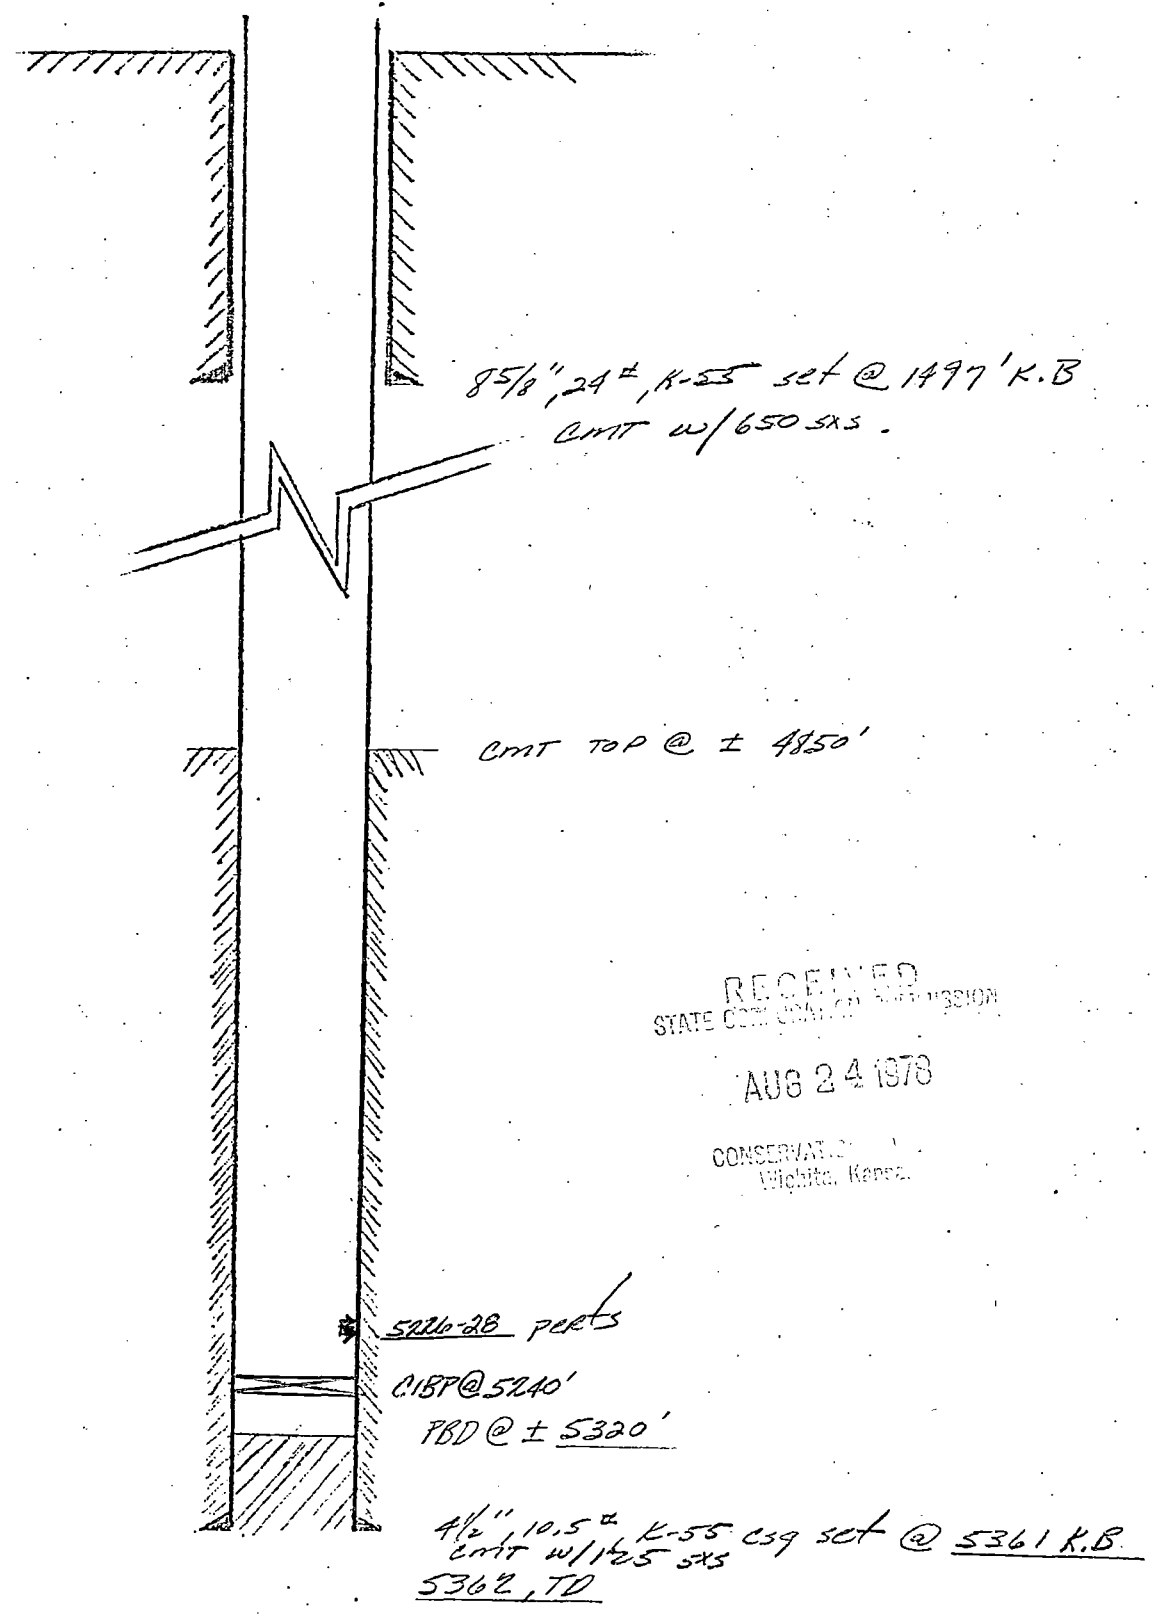

RECEIVED
STATE COMMISSION
AUG 24 1978
CONSERVATION
Wichita, Kansas