


STATE OF KANSAS
STATE CORPORATION COMMISSION

WELL PLUGGING RECORD

Give All Information Completely
Make Required Affidavit
Mail or Deliver Report to:
Conservation Division
State Corporation Commission
800 Bitting Building
Wichita, Kansas

Stanton County. Sec. 26 Twp. 30S Rge. 42 ~~W~~ (W)
Location as "NE/CNW/SW" or footage from lines C SW/4
Lease Owner J.M. Huber Corp.
Lease Name Bierig Well No. 1
Office Address Box 978, Liberal, Kansas
Character of Well (completed as Oil, Gas or Dry Hole) Dry Hole
Date well completed 3-12-56 19
Application for plugging filed 3-12-56 19
Application for plugging approved 3-12-56 19
Plugging commenced 3-12-56 19
Plugging completed 3-12-56 19
Reason for abandonment of well or producing formation Dry Hole

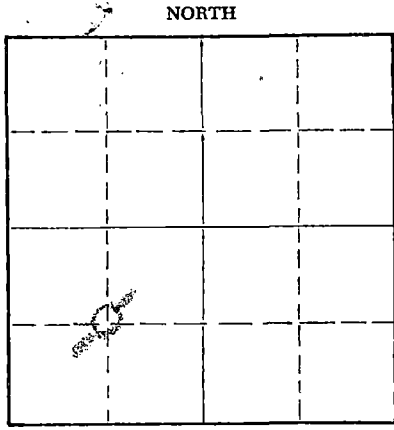

Locate well correctly on above
Section Plat

If a producing well is abandoned, date of last production _____ 19____
Was permission obtained from the Conservation Division or its agents before plugging was commenced? Yes

Name of Conservation Agent who supervised plugging of this well M.A. Rives
Producing formation _____ Depth to top _____ Bottom _____ Total Depth of Well 5375 Feet
Show depth and thickness of all water, oil and gas formations.

OIL, GAS OR WATER RECORDS CASING RECORD

FORMATION	CONTENT	FROM	TO	SIZE	PUT IN	PULLED OUT
				8 5/8	1520'	None

Describe in detail the manner in which the well was plugged, indicating where the mud fluid was placed and the method or methods used in introducing it into the hole. If cement or other plugs were used, state the character of same and depth placed, from _____ feet to _____ feet for each plug set.

Filled hole with mud to 600'. Pushed Halliburton Plug to 600'
and cemented through pipe with 35 sacks. Filled hole to 35';
pushed Halliburton Plug to 35'. Filled to surface with 15
sacks of cement.

(If additional description is necessary, use BACK of this sheet)

Name of Plugging Contractor J. M. Huber Corp.
Address Box 831, Borger, Texas

STATE OF Kansas, COUNTY OF Seward, ss.
W. W. Henson (employee of owner) or (Notary Public) of the above-described well, being first duly sworn on oath, says: That I have knowledge of the facts, statements, and matters herein contained and the log of the above-described well as filed and that the same are true and correct. So help me God.

(Signature) W. W. Henson
Box 978, Liberal, Kansas
(Address)

SUBSCRIBED AND SWORN to before me this 16 day of March, 19 56

My commission expires 7-27-57

J. R. Kyler
Notary Public.

PLUGGING
FILE SEC 26 T 30 R 42 W
BOOK PAGE 45 LINE 39

RECEIVED
CONSERVATION DIVISION
WICHITA, KANSAS
3-17-1956

WELL LOG

WELL NAME: Bierig #1

WELL LOCATION: Center SW/4 Section 26, T30S, R42W,
Stanton County, Kansas

WELL OWNER: J. M. Huber Corp.

DRILLING COMMENCED: 2-25-56

DRILLING COMPLETED: 3-10-56

WELL COMPLETED: 3-12-56

TOTAL DEPTH: 5375'

<u>FORMATION</u>	<u>DEPTH</u>
Clay, sand	0 - 160
Redbed	160 - 173
Clay, shells	173 - 205
Shale, sand & redbed	205 - 680
Redbed, shale & shells	680 - 1014
Shale, shells, sand	1014 - 1078
Shale, gype, anhydrite	1078 - 1132
Anhydrite	1132 - 1143
Redbed, sand, shells	1143 - 1278
Sand	1278 - 1300
Redbed, shells, sand	1300 - 1475
Anhydrite	1475 - 1520
Redbed, shells, shale	1520 - 1970
Shale	1970 - 2200
Shale & shells	2200 - 2250
Shale, shells, redbed	2250 - 2535
Shale, shells	2535 - 2600
Lime, shale	2600 - 3530
Lime	3530 - 3644
Lime & shale	3644 - 3790
Lime	3790 - 4027
Lime & shale	4027 - 4134
Lime	4134 - 4242
Lime & shale	4242 - 4366
Lime	4366 - 4416
Lime & chert	4416 - 4500
Lime & shale	4500 - 4593
Lime	4593 - 4676
Hard Lime	4676 - 4742
Lime & shale	4742 - 4869
Shale	4869 - 5150
Lime & shale	5150 - 5260
Shale & sand	5260 - 5274
Lime & sand	5274 - 5338
Lime	5338 - 5375'
Total Depth	5375'

PLUGGING
 FILE SEC 26 T 30 R 42W
 BOOK PAGE 45 LINE 39

Well Log
Bierig #1
Page 2

STATE OF KANSAS, COUNTY OF SEWARD, SS:

W. W. Henson, employee of owner of the above-described well being first duly sworn on oath, says: That I have knowledge of facts, statements and matters herein contained and the log of the above-described well as filed and that the same are true and correct.

W. W. Henson

Subscribed and sworn to before me this 16 day of March, 1956.

J. R. Keylee
Notary Public

My commission expires: 7-27-57.

PLUGGING
SEC 26 T 30 R 42 W
BOOK PAGE 45 LINE 39