


WELL PLUGGING RECORD

Give All Information Completely
Make Required Affidavit
Mail or Deliver Report to:
Conservation Division
State Corporation Commission
211 No. Broadway
Wichita, Kansas

Stanton County. Sec 25 Twp. 30S Rge. (E)42 (W)

Location as "NE/CNW%SW%" or footage from lines C NE SW
Lease Owner Whitestone Petroleum Corporation
Lease Name K. U. ENDOW Well No. 1
Office Address 900 Vaughn Building, Dallas 1, Texas
Character of Well (completed as Oil, Gas or Dry Hole) Dry Hole
Date well completed November 4 19 62
Application for plugging filed November 4 19 62
Application for plugging approved November 4 19 62
Plugging commenced November 4 19 62
Plugging completed November 4 19 62
Reason for abandonment of well or producing formation No commercial zones

NORTH

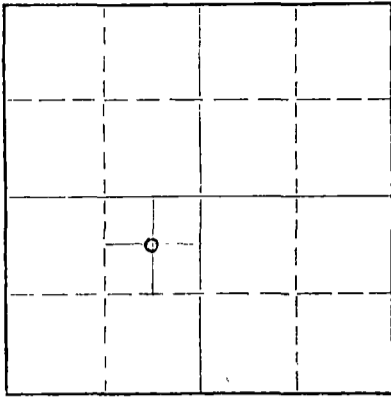

Locate well correctly on above Section Plat

If a producing well is abandoned, date of last production - - 19 --
Was permission obtained from the Conservation Division or its agents before plugging was commenced? Yes

Name of Conservation Agent who supervised plugging of this well Mr. Hugh Scott
Producing formation - - Depth to top - - Bottom - - Total Depth of Well 5600 Feet
Show depth and thickness of all water, oil and gas formations.

OIL, GAS OR WATER RECORDS

CASING RECORD

FORMATION	CONTENT	FROM	TO	SIZE	PUT IN	PULLED OUT
				8-5/8"	1524'	0

Describe in detail the manner in which the well was plugged, indicating where the mud fluid was placed and the method or methods used in introducing it into the hole. If cement or other plugs were used, state the character of same and depth placed, from _____ feet to _____ feet for each plug set.

Cement was pumped in hole through drill pipe and one 35-sack plug was placed from 795' to 700', and a second plug of 15 sacks was placed from 35' to surface of the ground. The remainder of the hole was filled with 9#/gallon drilling mud.

RECEIVED
STATE CORPORATION COMMISSION

NOV 6 1962

CONSERVATION DIVISION
Wichita, Kansas

11-6-1962

(If additional description is necessary, use BACK of this sheet)
Name of Plugging Contractor The Halliburton Company
Address Elkhart, Kansas

STATE OF TEXAS, COUNTY OF DALLAS, SS.
Dale O. Chase (employee of owner) or (~~owner of well~~) of the above-described well, being first duly sworn on oath, says: That I have knowledge of the facts, statements, and matters herein contained and the log of the above-described well as filed and that the same are true and correct. So help me God.

(Signature) Dale O. Chase
900 Vaughn Building, Dallas 1, Texas
(Address)

SUBSCRIBED AND SWORN TO before me this 5th day of November, 19 62

My commission expires 6/1/63 Emmale Coady Notary Public.

