

STATE OF KANSAS
STATE CORPORATION COMMISSION

WELL PLUGGING RECORD

Give All Information Completely
Make Required Affidavit
Mail or Deliver Report to
Conservation Division
State Corporation Comm.
245 North Water
Wichita, KS 67202

Stanton County, Sec. 25 Twp. 30S Rge. 42W E/W
Location as "NE/CNW $\frac{1}{4}$ SW $\frac{1}{4}$ " or footage from lines
NE/4

Lease Owner Herndon Drilling Company
Lease Name Baughman Well No. 1
Office Address 324 S. Main, Box 489, Tulsa, Ok. 74101
Character of Well (Completed as Oil, Gas or Dry Hole) dry hole


Date Well completed 2-6 1978
Application for plugging filed 2-6 1978
Application for plugging approved 2-6 1978
Plugging commenced 2-6 1978
Plugging completed 2-6 1978

Reason for abandonment of well or producing formation
no commercial quantities of oil or gas encountered

If a producing well is abandoned, date of last production
19

Was permission obtained from the Conservation Division or
its agents before plugging was commenced? yes

Name of Conservation Agent who supervised plugging of this well Wm. Owens
Producing formation _____ Depth to top _____ Bottom _____ Total Depth of Well 5650
Show depth and thickness of all water, oil and gas formations.

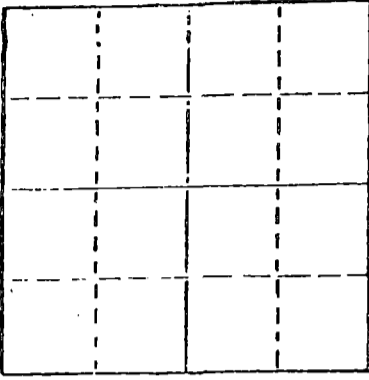

Locate well correctly on above
Section Plot

OIL, GAS OR WATER RECORDS

CASING RECORD

| FORMATION | CONTENT | FROM | TO | SIZE | PUT IN | PULLED OUT |
|--------------|---------|------|-------|-------|--------|------------|
| surface hole | shale | surf | 1530' | 8-5/8 | 1530 | none |
| | | | | | | |
| | | | | | | |

Describe in detail the manner in which the well was plugged, indicating where the mud fluid was placed and the method or methods used in introducing it into the hold. If cement or other plugs were used, state the character of same and depth placed, from _____ feet to _____ feet for each plug set.

RECEIVED
STATE CORPORATION COMMISSION

FEB 14 1978 2-14-1978

Fluid to 900', plug, 70 sx
Fluid to 300', plug, 20 sx
Fluid to 40', plug, 10 sx

(If additional description is necessary, use BACK of this sheet)

Name of Plugging Contractor D N B DRILLING, INC.
515 R. H. Garvey Building
Wichita, Kansas 67202

STATE OF Kansas COUNTY OF Sedgwick, ss.
Ella Priess (employee of owner) or (owner or operator)

of the above-described well, being first duly sworn on oath, says: That I have knowledge of the facts, statements, and matters herein contained and the log of the above-described well as filed and that the same are true and correct. So help me God.

(Signature) Ella Priess
Suite 515, R.H. Garvey Bldg., Wichita, Ks.
(Address) _____ 67202

SUBSCRIBED AND SWORN TO before me this 9th day of February, 19 78

My commission expires 4/30/79
Dorothy L. Schmidt
Dorothy L. Schmidt Notary Public.

DOROTHY L. SCHMIDT
STATE NOTARY PUBLIC
Sedgwick County, Kansas
My Appt. Exp. April 30, 1979

DRILLERS' LOG

HERNDON DRILLING COMPANY
No. 1 Baughman
NE/4 Sec. 25-30S-42W
Stanton Co., Kansas

Commenced: 1-21-78
Completed: 2-6-78

Surface Casing: 1523' of 8/58"
cemented w/650 sx Halco Lite, 2% cc,
150 sx common, 3% cc. 1-23-78

FORMATION

DEPTH

| | |
|--------------|-----------------|
| Surface Hole | 0 - 1530 |
| Shale | 1530 - 1575 |
| Shale & Lime | 1575 - 1997 |
| Sand & Shale | 1997 - 2221 |
| Shale | 2221 - 2584 |
| Shale & Lime | 2584 - 2781 |
| Shale | 2781 - 3399 |
| Shale & Lime | 3399 - 3620 |
| Lime & Shale | 3620 - 3790 |
| Sand & Shale | 3790 - 3983 |
| Lime & Shale | 3983 - 4560 |
| Shale | 4560 - 4682 |
| Lime | 4682 - 4858 |
| Shale | 4858 - 5180 |
| Shale & Lime | 5180 - 5440 |
| Lime | 5440 - 5650 RTD |

FEB 14 1978

I do hereby certify that the foregoing statements are true and correct to the best of my knowledge and belief.

D N B DRILLING, INC.

Ella Priess

Ella Priess

STATE OF KANSAS: ss:

Subscribed and sworn to before me this 9th day of February, 1978.

Dorothy L. Schmidt

Dorothy L. Schmidt, Notary Public

| |
|--|
| DOROTHY L. SCHMIDT STATE NOTARY PUBLIC Sedgwick County, Kansas My Appt. Exp. April 30, 1979 |
|--|