

15.187.00049.00.00


STATE OF KANSAS
STATE CORPORATION COMMISSION

Give All Information Completely
Make Required Affidavit
Mail or Deliver Report to:
Conservation Division
State Corporation Commission
211 No. Broadway
Wichita, Kansas

WELL PLUGGING RECORD

Stanton County, Sec. 19 Twp. 30S Rge. 42W (E) W (W)

Location as "NE/CNW&SW" or footage from lines C-SE/4
Lease Owner The Superior Oil Company
Lease Name Hume Well No. 1-19
Office Address Box 690, Chickasha, Oklahoma
Character of Well (completed as Oil, Gas or Dry Hole) Dry Hole
Date well completed February 23, 19 57
Application for plugging filed February 23, 19 57
Application for plugging approved February 23, 19 57
Plugging commenced February 23, 19 57
Plugging completed March 4, 19 57
Reason for abandonment of well or producing formation Dry Hole

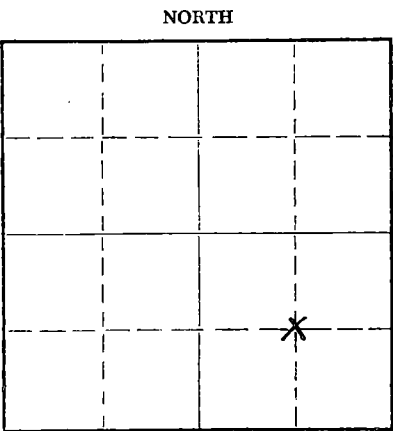

Locate well correctly on above Section Plat

If a producing well is abandoned, date of last production _____ 19 ____
Was permission obtained from the Conservation Division or its agents before plugging was commenced? Yes

Name of Conservation Agent who supervised plugging of this well Mr. M. A. Rives
Producing formation _____ Depth to top _____ Bottom _____ Total Depth of Well 5477 Feet
Show depth and thickness of all water, oil and gas formations.

OIL, GAS OR WATER RECORDS

CASING RECORD

FORMATION	CONTENT	FROM	TO	SIZE	PUT IN	PULLED OUT
None				10-3/4"	1518 Ft.	None

Describe in detail the manner in which the well was plugged, indicating where the mud fluid was placed and the method or methods used in introducing it into the hole. If cement or other plugs were used, state the character of same and depth placed, from _____ feet to _____ feet for each plug set.

Placed 100 sack cement plug at 5476.
Placed wooden plug and 35 sacks cement at 600 ft.
Placed wooden plug 28 ft. below base of cellar. Filled to surface with cement.
Welded on steel cap.

RECEIVED
STATE CORPORATION COMMISSION

MAR 12 1957

CONSERVATION DIVISION
Wichita, Kansas 3-12-1957

(If additional description is necessary, use BACK of this sheet)
Name of Plugging Contractor Cox Drilling Co. (rotary)
Address Wichita Falls, Texas

STATE OF Oklahoma, COUNTY OF Grady, ss.
G. Bannantine (employee of owner) or (owner or operator) of the above-described well, being first duly sworn on oath, says: That I have knowledge of the facts, statements, and matters herein contained and the log of the above-described well as filed and that the same are true and correct. So help me God.

(Signature) G. Bannantine
Box 690, Chickasha, Oklahoma
(Address)

SUBSCRIBED AND SWORN TO before me this 11th day of March, 19 57

My commission expires Sept. 15, 1960

M. F. Fiegel
Notary Public.

PLUGGING
FILE SEC 19 T 30 R 42W
BOOK PAGE 143 LINE 21

THE SUPERIOR OIL COMPANYHUME #1-19

SE/4-Section 19-30S-42W Stanton Co. Kansas

Shale	0 - 110
Sand and shale	110 - 222
Shale & sand streaks	222 - 450
Shale and lime	450 - 712
Shale	712 - 1014
Shale and shells	1014 - 1144
Lime	1144 - 1171
Shale	1171 - 1520
lime and shale	1520 - 1550
Shale & lime streaks	1550 - 2491
Shale and shells	2491 - 2673
Shale & lime streaks	2673 - 3208
Shale and shells	3208 - 3339
Shale	3339 - 3344
Shale and shells	3344 - 3494
Hard lime	3494 - 3520
Lime and shale	3520 - 3781
Lime and shale	3781 - 3861
Sand	3861 - 3877
Lime and shale	3877 - 4111
Lime & shale streaks	4111 - 4256
Shale and lime	4256 - 4304
Sandy lime	4304 - 4355
Lime and shale	4355 - 4438
Lime w/shale streaks	4438 - 4489
Lime and shale	4489 - 4660
Lime	4660 - 4680
Shale	4680 - 4700
Lime	4700 - 4707
Hard lime	4707 - 4799
Shale and lime	4799 - 4840
Hard lime	4840 - 4914
Shale and lime	4914 - 5081
Shale	5081 - 5190
Hard Shale	5190 - 5220
Sand & shells	5220 - 5301
Sand & lime	5301 - 5346
Sand & shale	5346 - 5440
Limy sand	5440 - 5449
Lime	5449 - 5477
T.D.	

RECEIVED
STATE CORPORATION COMMISSION

FEB 26 1957

CONSERVATION DIVISION
Topeka, Kansas

PLUGGING
FILE SEC 19 T 30 R 42W
BOOK PAGE 143 LINE 21