

STATE OF KANSAS
STATE CORPORATION COMMISSION

WELL PLUGGING RECORD

Give All Information Completely
Make Required Affidavit
Mail or Deliver Report to:
Conservation Division
State Corporation Commission
800 Bitting Building
Wichita, Kansas

Stanton County, Sec. 18 Twp. 30 Rge. 42 (E) (W)

Location as "NE/CNW/SW" or footage from lines C-S.W./4

Lease Owner Killam & Hurd

Lease Name Rorick Well No. 1

Office Address Laredo, Texas

Character of Well (completed as Oil, Gas or Dry Hole) Dry Hole

Date well completed 6-7 1956

Application for plugging filed 6-7 1956

Application for plugging approved 6-7 1956

Plugging commenced 6-7 1956


Plugging completed 6-7 1956

Reason for abandonment of well or producing formation

No show of Oil or Gas

If a producing well is abandoned, date of last production - 19

Was permission obtained from the Conservation Division or its agents before plugging was commenced? Yes

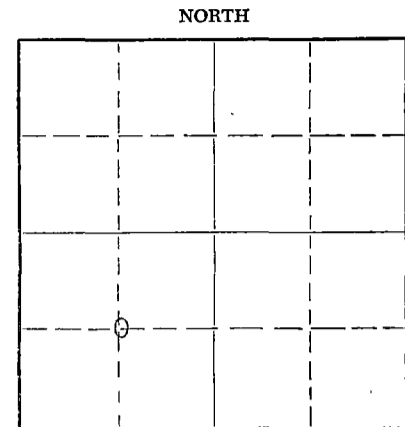

Locate well correctly on above Section Plat

Name of Conservation Agent who supervised plugging of this well Merle Rives, Pratt, Kansas

Producing formation None Depth to top Bottom Total Depth of Well 5475 Feet

Show depth and thickness of all water, oil and gas formations.

OIL, GAS OR WATER RECORDS

CASING RECORD

FORMATION	CONTENT	FROM	TO	SIZE	PUT IN	PULLED OUT
				8 5/8	1509'	None

Describe in detail the manner in which the well was plugged, indicating where the mud fluid was placed and the method or methods used in introducing it into the hole. If cement or other plugs were used, state the character of same and depth placed, from feet to feet for each plug set.

Filled hole with heavy rotary mud to 600' from surface

Set Halliburton plug at 600'

Spotted 35 sacks cement on top of plug by Halliburton

Filled hole with rotary mud to 35' from surface

Set wooden plug at 35'

Dumped 1/4 sack of hulls on plug

Filled hole from that point with cement to bottom of cellar

(If additional description is necessary, use BACK of this sheet)

Name of Plugging Contractor Holm Drilling Company
Address Box 7246, Tulsa, Oklahoma

STATE OF Oklahoma, COUNTY OF Tulsa, ss.

Harold W. Stoops (employee of owner) or (owner or operator) of the above-described well, being first duly sworn on oath, says: That I have knowledge of the facts, statements, and matters herein contained and the log of the above-described well as filed and that the same are true and correct. So help me God.

(Signature) Harold W. Stoops
Box 737 Oklahoma, Kansas
(Address)

SUBSCRIBED AND SWORN TO before me this 7 day of June, 1956

My commission expires February 25, 1957

Kanda L. Knight Notary Public.

PLUGGING
FILE SEC 18 T 30 R 42W
BOOK PAGE 70 LINE 14

JUN 26 1956
CONSERVATION DIVISION
Wichita, Kansas
6-26-1956

WELL LOG
Rorick Unit #1 Well

Location: Sec. 18-30S-42W, Stanton County, Kansas
 Operator: Killam and Hurd Inc.
 Contractor: Holm Drilling Company
 Commenced: 5-11-56
 Spud: 5-11-56
 Rotary Work Completed: 6-6-56
 Rotary Depth: 5475'
 Casing Record: 8 5/8" set at 1509' Ground Level

<u>Formation</u>	<u>Depth</u>
Surface Clay & Sand	259'
Sand, Red Bed, & Shells	700'
Sand & Shale	722'
Gyp	750'
Gyp and Shale	765'
Sand & Shale	1020'
Shale	1075'
Lime	1125'
Gyp	1160'
Gyp & Shale	1286'
Sand, Shells & Red Bed	1425'
Sand & Shale	1485'
Gyp & Anhydrite	1495'
Anhydrite	1525'
Shale & Shells	2340'
Shale & Lime	3433'
Lime	3495'
Lime & Shale	3618'
Lime	3655'
Lime & Shale	4174'
Lime, Shale & Sand	4191'
Lime & Shale	4299'
Lime	4348'
Lime & Shells	4375'
Lime & Shale	4391'
Lime	4480'
Lime & Shale	4675'
Lime	4683'
Lime & Shale	4984'
Shale	5318'
Shale & Sand	5370'
Sand	5380'
Shale, Lime, & Sand	5417'
Sand	5436'
Sand & Shale	5475' T.D.

Certified Copy of Well Log

HOLM DRILLING COMPANY

By

F. M. Rush
 F. M. Rush

PLUGGING
FILE SEC. <u>18</u> T. <u>30</u> R. <u>42W</u>
BOOK PAGE <u>70</u> L.I.E. <u>14</u>