


STATE OF KANSAS  
STATE CORPORATION COMMISSION

Give All Information Completely  
Make Required Affidavit  
Mail or Deliver Report to:  
Conservation Division  
State Corporation Commission  
800 Bittling Building  
Wichita, Kansas

WELL PLUGGING RECORD

Stanton County, Sec. 7 Twp. 30S Rge. 42 (E) W (W)  
Location as "NE/CNW/SW" or footage from lines SE SW  
Lease Owner Robert J. Beams  
Lease Name Kilgore Unit Well No. 1  
Office Address 1201 Gulf States Building, Dallas, Texas  
Character of Well (completed as Oil, Gas or Dry Hole) Dry hole  
Date well completed July 4, 19 58  
Application for plugging filed July 3, (phone) 19 58  
Application for plugging approved July 3, (phone) 19 58  
Plugging commenced July 3, 19 58  
Plugging completed July 3, 19 58  
Reason for abandonment of well or producing formation Dry hole

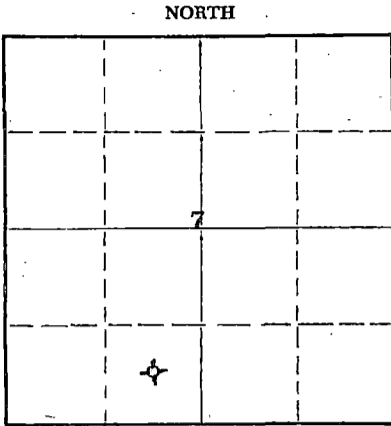

Locate well correctly on above Section Plat

If a producing well is abandoned, date of last production 19  
Was permission obtained from the Conservation Division or its agents before plugging was commenced? Yes

Name of Conservation Agent who supervised plugging of this well M. A. Rives, Garden City, Kansas  
Producing formation Depth to top Bottom Total Depth of Well 5440 KBfeet  
Show depth and thickness of all water, oil and gas formations.

OIL, GAS OR WATER RECORDS

CASING RECORD

FORMATION	CONTENT	FROM	TO	SIZE	PUT IN	PULLED OUT
Sand and clay		0'	530'			
Red bed and shale		530'	1080'			
Red bed, shale and anhydrite		1080'	1514'	8-5/8"	1514'	None

Describe in detail the manner in which the well was plugged, indicating where the mud fluid was placed and the method or methods used in introducing it into the hole. If cement or other plugs were used, state the character of same and depth placed, from feet to feet for each plug set.

Filled hole with heavy rotary mud from 5440' to 550'. Set wooden plug at 550' with 1/2 sack of hulls and 20 sacks of cement. Cement through open-end drill pipe filled hole with mud from 550' to 40'. Set top wooden plug at 40' with 10 sacks of cement through open-end drill pipe to bottom of cellar. Plugging completed.

7-11-1958

STATE CORPORATION COMMISSION

JUL 11 1958

CONSERVATION DIVISION  
Wichita, Kansas

(If additional description is necessary, use BACK of this sheet)

Name of Plugging Contractor The R. W. Rine Drilling Company  
Address 420 Union Center, Wichita 2, Kansas

STATE OF KANSAS, COUNTY OF SEDGWICK  
R. M. GREEN (Conservation Agent for Operator)  
well, being first duly sworn on oath, says: That I have knowledge of the facts, statements, and matters herein contained and the log of the above-described well as filed and that the same are true and correct. So help me God.

(Signature) ROBERT J. BEAMS

By: Edna Landry (Conservation Agent for Operator)

SUBSCRIBED AND SWORN TO before me this 9th day of July, 19 58

Edna Landry

Notary Public.

My commission expires July 9, 1960.

PLUGGING  
FILE SEC 7 T 30 R 42W  
BOOK PAGE 113 LINE 13

15.187.10000-00.00

Se SW  
Sec. 7-30S-42W  
Stanton County, Kansas

KILGORE UNIT NO. 1

CONTRACTOR: The R. W. Rine Drilling Co.

STARTED: June 14, 1958

COMPLETED: July 4, 1958

	L	O	G	
	-	-	-	
Dirt & Sand	0'	-	41'	
Sand & Clay	41'	-	530'	Syfo. @200' 1/2 <sup>o</sup> , @450' 1/2 <sup>o</sup>
Red Bed	530'	-	905'	Syfo. @890' 3/4
Red Bed & Shale	905'	-	1080'	
Anhydrite	1080'	-	1150'	Syfo. @1100' 1/2 <sup>o</sup>
Anhydrite & Red	1150'	-	1306'	
Red Bed, Shale & Anhydrite	1306'	-	1500'	Syfo. @1400' 1/2 <sup>o</sup>
Anhydrite	1500'	-	1516'	8-5/8" Csg. @1514' W/600 Sx.
Gyp & Shells	1516'	-	1830'	Syfo. @1800' 1/2 <sup>o</sup>
Red Bed & Shale	1830'	-	2220'	Syfo. @2050' 1/2 <sup>o</sup> , @2085' 1 <sup>o</sup>
Shale & Lime	2220'	-	3467'	Syfo. @2400' 1 <sup>o</sup> , @2485' 1 <sup>o</sup>
				Syfo. @2655' 1/4 <sup>o</sup> , @2835' 1/2 <sup>o</sup>
				Syfo. @3175' 3/4 <sup>o</sup> , @3400' 1/4 <sup>o</sup>
Lime	3467'	-	3992'	Syfo. @3563' 1/2 <sup>o</sup> , @3700' 1/2 <sup>o</sup>
				Syfo. @3887' 2 <sup>o</sup>
Lime & Shale	3992'	-	4012'	Syfo. @3950' 2 <sup>o</sup>
Lime	4012'	-	4517'	Syfo. @4010' 2-1/4 <sup>o</sup> , @4090' 2 <sup>o</sup>
				Syfo. @4275' 1-1/4 <sup>o</sup> , @4360' 1-3/4 <sup>o</sup>
				Syfo. @4515' 1-3/4 <sup>o</sup>
Lime & Shale	4517'	-	4583'	
Lime	4583'	-	4822'	Syfo. @4640' 1-1/2 <sup>o</sup> , @4695' 1-3/4 <sup>o</sup>
Shale & Lime	4822'	-	5035'	Syfo. @4864' 3-1/4 <sup>o</sup>
Shale	5035'	-	5266'	Syfo. @5102' 3 <sup>o</sup>
Lime	5266'	-	5291'	
Lime, Shale & Sand	5291'	-	5318'	Syfo. @5285' 4 <sup>o</sup>
Lime & Sand	5318'	-	5348'	
Lime	5348'	-	5382'	
Shale & Sand	5382'	-	5418'	
Lime & Sand	5418'	-	5440'	
				T.D.
				D.A.

STATE OF KANSAS )  
COUNTY OF SEDGWICK) ss

I, R. M. Green, do hereby certify that the above is a true and accurate log of the Kilgore Unit Well No. 1, located SE SW of Sec. 7-30S-42W, Stanton County, Kansas.

*R. M. Green*  
Secretary and Treasurer

Subscribed and sworn to before me this 9th day of July, 1958.

*Ben E. Eaker*  
NOTARY PUBLIC

My Commission Expires: 6/14/62

FILED  
STATE OF KANSAS  
COMMISSIONER

JUL 11 1958

CONSTITUTIONAL PROVISION

PLUGGING  
FILE SEC 7 T 30 R 42W  
BOOK PAGE 113 LINE 13