


STATE OF KANSAS
STATE CORPORATION COMMISSION

WELL PLUGGING RECORD

Give All Information Completely
Make Required Affidavit
Mail or Deliver Report to:
Conservation Division
State Corporation Commission
211 No. Broadway
Wichita, Kansas

Stanton County. Sec. 6 Twp. 30S Rge. (E) 42 (W)
Location as "NE/CNW/SW" or footage from lines SW SE
Lease Owner Thomas & Brewer
Lease Name Kilgore Well No. 1
Office Address Box 1177, Liberal, Kansas
Character of Well (completed as Oil, Gas or Dry Hole) Dry Hole
Date well completed 6-22 1962
Application for plugging filed 6-22 1962
Application for plugging approved 6-22 1962
Plugging commenced 6-23 1962
Plugging completed 6-23 1962
Reason for abandonment of well or producing formation Dry Hole

NORTH

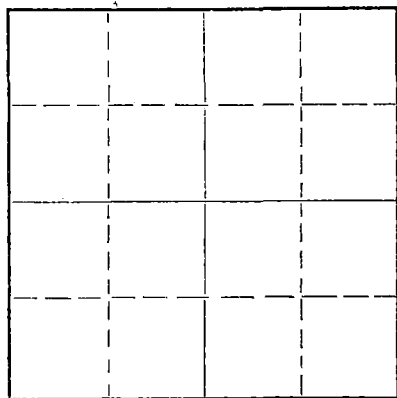

Locate well correctly on above Section Plat

If a producing well is abandoned, date of last production 19
Was permission obtained from the Conservation Division or its agents before plugging was commenced? yes

Name of Conservation Agent who supervised plugging of this well Hugh Scott
Producing formation none Depth to top Bottom Total Depth of Well 5520 Feet
Show depth and thickness of all water, oil and gas formations.

OIL, GAS OR WATER RECORDS

CASING RECORD

FORMATION	CONTENT	FROM	TO	SIZE	PUT IN	PULLED OUT
				8 5/8 "	1502'	none

Describe in detail the manner in which the well was plugged; indicating where the mud fluid was placed and the method or methods used in introducing it into the hole. If cement or other plugs were used, state the character of same and depth placed, from feet to feet for each plug set.

30 sx. at 750; 15 sx. 35' to surface

7-6-1962
RECEIVED
STATE CORPORATION COMMISSION
JUL 6 1962
CONSERVATION DIVISION

(If additional description is necessary, use BACK of this sheet)

Name of Plugging Contractor Roberts Drilling Co.
Address Russell, Kansas

STATE OF KANSAS, COUNTY OF SEWARD, ss.

(employee of owner) or (owner or operator) of the above-described well, being first duly sworn on oath, says: That I have knowledge of the facts, statements, and matters herein contained and the log of the above-described well as filed and that the same are true and correct. So help me God.

(Signature) *Thomas P. Thomas*

(Address)

SUBSCRIBED AND SWORN to before me this 23rd day of June, 1962

Marlene Keating
Notary Public.

My commission expires 11-5-1962



RE

THOMAS & BREWER
KILGORE #1

C SW SE Sec. 6-30-42W
Stanton County, Kansas

RTD 5520'

CONTRACTOR: Roberts Drilling Co.

Commenced 6/6/62
Completed 6/23/62

Set 8 5/8" Csg. @ 1502 w/ 675. sx

Surface Soil & Clay	40'
Sand & Sandy Shale	200
Blue Shale	260
Shale & Sand	335
Sand	565
Shale & Shells	735
Red Bed	743
Anhydrite & Gypsum	784
Sand & Shale	836
Red Bed	865
Sand & Red Bed	940
Red Bed	1030
Sand	1095
Red Bed	1107
Gypsum & Anhydrite Streaks	1185
Red Bed	1485
Anhydrite	1540
Red Bed	1550
Red Bed & Shale	2200
Shale & Lime	2955
Shale & Chalk	3010
Lime & Chalk	3495
Lime	3550
Lime & Chalk	3660
Lime & Shale	3930
Lime	3980
Lime & Shale	4170
Lime	4260
Lime & Shale	4355
Lime	4400
Lime & Shale	4665
Cherty Lime	4714
Lime	4811
Lime & Shale	5059
Shale	5300
Shale & Sand	5380
Cherty Lime	5428
Lime & Sand	5451
Lime	5520

RECEIVED
STATE CORPORATION COMMISSION
JUL 16 1962
CONSERVATION DIVISION
Wichita, Kansas

STATE OF KANSAS, COUNTY OF RUSSELL

I hereby certify that the above information is correct to the best of my knowledge.

ROBERTS DRILLING CO.

By Mildred Belbey

Subscribed and sworn to before me this 11th day of July, 1962.

Clara Hummel
Notary Public

My Commission Expires 6/17/66