


WELL PLUGGING RECORD

Give All Information Completely  
Make Required Affidavit  
Mail or Deliver Report to:  
Conservation Division  
State Corporation Commission  
211 No. Broadway  
Wichita, Kansas

Stanton County, Sec. 36 Twp. 30S Rge. (E) 41 (W)  
Location as "NE/CNW/SW" or footage from lines C NE/4 SW/4  
Lease Owner The Hefner Production Company  
Lease Name Walker Well No. 1  
Office Address 720 Northwest 50th St., Oklahoma City 18, Oklahoma  
Character of Well (completed as Oil, Gas or Dry Hole) Dry Hole  
Date well completed May 4 1963  
Application for plugging filed " 19  
Application for plugging approved May 5 19 63  
Plugging commenced May 4 19 63  
Plugging completed May 4 19 63  
Reason for abandonment of well or producing formation Dry Hole

NORTH

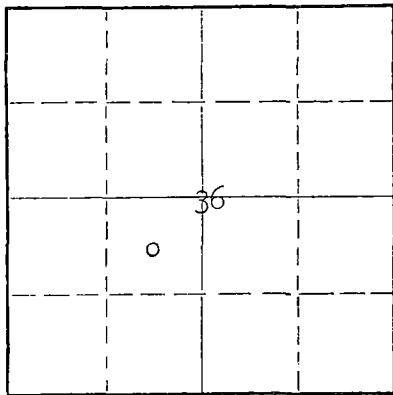

Locate well correctly on above Section Plat

If a producing well is abandoned, date of last production 19  
Was permission obtained from the Conservation Division or its agents before plugging was commenced? Yes

Name of Conservation Agent who supervised plugging of this well Hugh Scott, Sublette, Kansas  
Producing formation None Depth to top Bottom Total Depth of Well 5600 Feet  
Show depth and thickness of all water, oil and gas formations.

OIL, GAS OR WATER RECORDS

CASING RECORD

FORMATION	CONTENT	FROM	TO	SIZE	PUT IN	PULLED OUT
				8 5/8"	1585'	None

Describe in detail the manner in which the well was plugged, indicating where the mud fluid was placed and the method or methods used in introducing it into the hole. If cement or other plugs were used, state the character of same and depth placed, from feet to feet for each plug set.

Plugged well with 20 sacks cement @ 1560'; 20 sacks cement @ 540' and 10 sacks cement in cellar.

5-20-1963

RECEIVED  
STATE CORPORATION COMMISSION

MAY 20 1963

CONSERVATION DIVISION  
Wichita, Kansas

(If additional description is necessary, use BACK of this sheet)

Name of Plugging Contractor Holm Drilling Company  
Address 1036 East 38th Place, Tulsa, Oklahoma

STATE OF Oklahoma, COUNTY OF Oklahoma, ss.  
Harry H. Hurd (employee of owner) of the above-described well, being first duly sworn on oath, says: That I have knowledge of the facts, statements, and matters herein contained and the log of the above-described well as filed and that the same are true and correct. So help me God.

(Signature) Harry H. Hurd  
720 N.W. 50th St., Okla. City, Okla.  
(Address)

SUBSCRIBED AND SWORN TO before me this 17th day of May, 19 63

My commission expires Feb. 14, 1965

Emily C. Culver  
Notary Public.



DRILLERS'S LOG

WELL NAME Walker No. 1

COMPANY OPERATING The Hefner Production Company  
 ADDRESS OF COMPANY 720 N.W. 50th, Okla. City, Okla

WELL LOCATION C  $\frac{1}{4}$  NE  $\frac{1}{4}$  SW  $\frac{1}{4}$ ,  
1980 ft. North of South line,  
1980 ft. East of West line, Sec. 36 Twp. 30S Rge. 41S, Stanton County, Kansas

DRILLING STARTED April 19, 19 63  
 WELL COMPLETED May 4, 19 63

DRILLING COMPLETED May 4, 19 63  
 WELL CONNECTED \_\_\_\_\_, 19 \_\_\_\_\_

ELEVATION 3372 ft. Ground Level CHARACTER OF WELL (Oil, Gas, or Dry Hole) Dry Hole

OIL OR GAS, SAND OR ZONES - PERFORATIONS - ACIDIZING AND FRACTURING INFORMATION					
Name	From	To	No. of Shots	Gallons Used	Kind Used
No producing formations					

CASING RECORD

Size	Amount Set	Sacks of Cement	Amount Pulled
8 5/8"	1585'	580	None

FORMATION RECORD

Formation	Top	Bottom	Formation	Top	Bottom
Surf. clay & Sd	0	170	Im	3895	3969
Sh, Sd & shells	170	616	Im w/chalk	3969	4005
Redbeds and Sd	616	1103	Im & Sh	4005	4285
Gyp	1103	1135	Im	4285	4850
Redbeds & Sd	1135	1565	Im & Sh	4850	5045
Sh and shells	1565	1570	Sh	5045	5225
Anhyd.	1570	1595	Sh & Im	5225	5335
Sh & shells	1595	2310	Sd	5335	5346
Sh & Im	2310	3150	Sdy Im	5346	5360
Im	3150	3325	Sh & Sd	5360	5388
Im & Sh	3325	3562	Im & Sd	5388	5474
Im	3562	3749	Im	5474	5600
Im & Sh	3749	3895			

RECEIVED  
 STATE CORPORATION COMMISSION  
 MAY 20 1963  
 CONSERVATION DIVISION  
 Wichita, Kansas

RESULTS OF INITIAL PRODUCTION TEST: None