

STATE OF KANSAS
STATE CORPORATION COMMISSION


Form CP-4

Give All Information Completely
Make Required Affidavit
Mail or Deliver Report to:
Conservation Division
State Corporation Commission
212 No. Market
Wichita, Kansas

WELL PLUGGING RECORD

Stanton County, Sec. 28 Twp. 30S Rge. (E) 42 (W)

Location as "NE/CNW%SW%" or footage from lines C SW 1/4
Lease Owner The Superior Oil Company
Lease Name Kansas University Unit Well No. 1
Office Address P. O. Box 200, Casper, Wyoming 82601
Character of Well (completed as Oil, Gas or Dry Hole) Gas
Date well completed November 10 19 55
Application for plugging filed February 23 19 71
Application for plugging approved February 25 19 71
Plugging commenced April 8 19 71
Plugging completed April 11 19 71
Reason for abandonment of well or producing formation Depleted

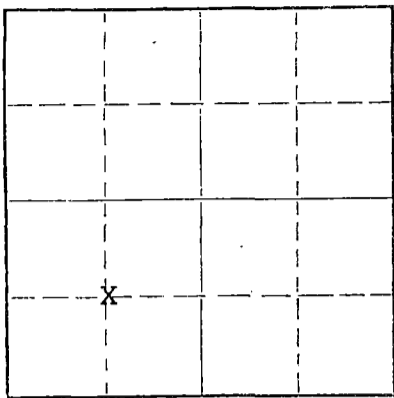

Locate well correctly on above Section Plat

If a producing well is abandoned, date of last production March 12 19 71
Was permission obtained from the Conservation Division or its agents before plugging was commenced? Yes

Name of Conservation Agent who supervised plugging of this well Mr. Eves
Producing formation Morrow Depth to top 5266 Bottom 5305 Total Depth of Well 5385 Feet
Show depth and thickness of all water, oil and gas formations.

OIL, GAS OR WATER RECORDS

CASING RECORD

FORMATION	CONTENT	FROM	TO	SIZE	PUT IN	PULLED OUT
Morrow	Gas	5266	5305	10-3/4"	1516	0
				7"	5385	3024'

Describe in detail the manner in which the well was plugged, indicating where the mud fluid was placed and the method or methods used in introducing it into the hole. If cement or other plugs were used, state the character of same and depth placed, from _____ feet to _____ feet for each plug set.

Mixed 25 sacks regular cement with 2-1/2 sacks cotton seed hulls, pumped down casing and spotted from 5100 to 5305 feet. Shot 7" casing. Pulled and recovered 3024' (98 jts.). Mixed 60 sacks regular cement. Pumped down hole and spotted from 700 to 800'. Filled hole with mud. Put 20 sacks regular cement from 40' to surface. Cut off surface pipe 3' below ground level and welded on cap.

RECEIVED
STATE CORPORATION COMMISSION
APR 20 1971 4-20-1971
CONSERVATION DIVISION
Wichita, Kansas

(If additional description is necessary, use BACK of this sheet)
Name of Plugging Contractor Sargent Casing Pullers
Address P. O. Box 506, Liberal, Kansas

STATE OF Wyoming, COUNTY OF Natrona, ss.
Herman High (employee of owner) or (owner or operator) of the above-described well, being first duly sworn on oath, says: That I have knowledge of the facts, statements, and matters herein contained and the log of the above-described well as filed and that the same are true and correct. So help me God.

(Signature) Herman High District Engineer
P. O. Box 200, Casper, Wyoming 82601
(Address)

SUBSCRIBED AND SWORN to before me this 19th day of April, 1971

Jeanette H. Parke Notary Public

My commission expires August 21, 1971