

STATE OF KANSAS
STATE CORPORATION COMMISSION

WELL PLUGGING RECORD

Give All Information Completely
Make Required Affidavit
Mail or Deliver Report to:
Conservation Division
State Corporation Commission
211 No. Broadway
Wichita, Kansas

Stanton

County. Sec. 33 Twp. 30 Rge. 43 (W)

Location as "NE/CNW^{1/4}/SW^{1/4}" or footage from lines 1420' WEL & 1320' NSL

Lease Owner Rupp-Ferguson Oil Company, et al.

Lease Name Israel Well No. 1

Office Address 522 Union Center, Wichita 2, Kansas

Character of Well (completed as Oil, Gas or Dry Hole) Dry Hole

Date well completed January 4 1960

Application for plugging filed January 4 1960

Application for plugging approved January 4 1960


Plugging commenced January 4 1960

Plugging completed January 5 1960

Reason for abandonment of well or producing formation Dry Hole

If a producing well is abandoned, date of last production None 19

Was permission obtained from the Conservation Division or its agents before plugging was commenced? Yes

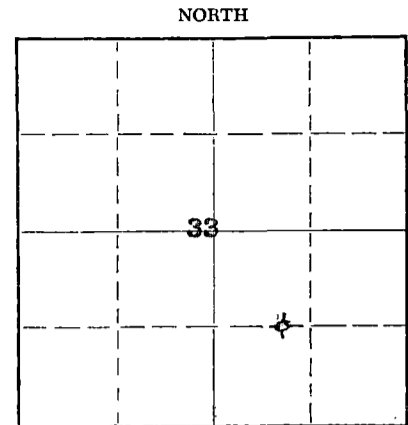

Locate well correctly on above Section Plat

Name of Conservation Agent who supervised plugging of this well Mr. Frank Broadfoot

Producing formation None Depth to top Bottom Total Depth of Well 5615 Feet

Show depth and thickness of all water, oil and gas formations.

OIL, GAS OR WATER RECORDS

CASING RECORD

FORMATION	CONTENT	FROM	TO	SIZE	PUT IN	PULLED OUT
	Sand, Shale, Salt	1160	1450	8-5/8	1514	-0-

Describe in detail the manner in which the well was plugged, indicating where the mud fluid was placed and the method or methods used in introducing it into the hole. If cement or other plugs were used, state the character of same and depth placed, from feet to feet for each plug set.

Cement plug #1 @ 2801' to 2506' w/ 100 sx. reg. cement, heavy mud to 1524';
cement plug #2 @ 1524' to 1413' w/ 40 sx. reg. cement, heavy mud to 40';
cement plug #3 @ 40' to bottom of cellar. Surface casing cut off even w/ bottom of cellar and steel cap welded over end of pipe.

RECEIVED
STATE CORPORATION COMMISSION

JAN 12 1960 1-12-1960

CONSERVATION DIVISION
Wichita, Kansas

Name of Plugging Contractor The R. W. Rine Drilling Company
Address 420 Union Center, Wichita 2, Kansas

STATE OF KANSAS COUNTY OF SEDGWICK, ss.
R. M. GREEN (employee of owner) or (owner or operator) of the above-described

well, being first duly sworn on oath, says: That I have knowledge of the facts, statements, and matters herein contained and the log of the above-described well as filed and that the same are true and correct. So help me God.

(Signature) R. M. Green
The R. W. Rine Drilling Company
420 Union Center, Wichita 2, Kansas
(Address)

SUBSCRIBED AND SWORN TO before me this 7th day of January, 1960

Edna Landry
Notary Public.

My commission expires July 9, 1960



1420' WEL & 1320' NSL
 Sec. 33-30S-43W
 Stanton County, Kansas

ISRAEL WELL NO. 1

CONTRACTOR: The R. W. Rine Drilling Company

STARTED: December 18, 1959

COMPLETED: January 5, 1960

L O G

Surface - Sand & Shale	0' - 840'	Syfo. @200' 1/2 ^o , @425' 1/4 ^o
		Syfo. @625' 3/4 ^o , @725' 1/2 ^o
Lime & Shale	840' - 1160'	Syfo. @930' 3/4 ^o
Sand, Shale & Salt	1160' - 1450'	Syfo. @1160' 1/2 ^o
Lime & Anhydrite	1450' - 1650'	8-5/8" Csg. @1514' W/600 Sx.
Shale & Lime	1650' - 2291'	Syfo. @2290' 1
Shale	2291' - 2555'	
Shale & Lime	2555' - 3455'	Syfo. @2655' 3/4 ^o , @2940' 1/2 ^o
		Syfo. @3236' 1/2 ^o , @3400' 1/2 ^o
Lime	3455' - 3546'	
Lime & Shale	3546' - 3860'	Syfo. @3844' 1 ^o
Lime	3860' - 3935'	
Lime & Shale	3935' - 5151'	Syfo. @3960' 1 ^o , @4175' 1-1/2 ^o
		Syfo. @4562' 1 ^o -1/4 ^o , @4875' 1-1/4 ^o
		Syfo. @5062' 1
Shale	5151' - 5410'	
Shale & Lime	5410' - 5450'	
Sand & Shale	5450' - 5522'	Syfo. @5475' 4-3/4 ^o
Shale & Lime	5522' - 5615'	Syfo. @5615' 4
	T. D.	Plug #1 @2801' W/100 Sx.
		Plug #2 @1524' W/40 Sx.
		Plug #3 @ 40' W/10 Sx.
		Cut off casing 4' below ground level and welded steel cap.

STATE OF KANSAS)
 COUNTY OF SEDGWICK) ss

I, R. M. Green, do hereby certify that the above is a true and accurate log of the Israel Well No. 1, located 1420' WEL & 1320' NSL of Sec. 33-30S-43W, Stanton County, Kansas.


 Secretary-Treasurer

Subscribed and sworn to before me this 7th day of January, 1960.


 NOTARY PUBLIC

My Commission Expires: 6/14/62