


STATE OF KANSAS
STATE CORPORATION COMMISSION

WELL PLUGGING RECORD

Give All Information Completely
Make Required Affidavit
Mail or Deliver Report to:
Conservation Division
State Corporation Commission
212 North Market, Insurance Bldg.
Wichita, Kansas

Stanton County, Sec. 22 Twp. 30S Rge. (E) 43W (W)

Location as "NE/CNW/SW" or footage from lines Center of SE 1/4
Lease Owner ROBINSON BROTHERS OIL PRODUCERS
Lease Name H. H. Hoopingarner Well No. 1
Office Address Box 430 Borger, Texas
Character of Well (completed as Oil, Gas or Dry Hole) Dry Hole
Date well completed November 15 1960
Application for plugging filed December 7 1960
Application for plugging approved November 15 1960
Plugging commenced 4 P.M. November 15 1960
Plugging completed 12 P.M. November 15 1960
Reason for abandonment of well or producing formation Dry Hole

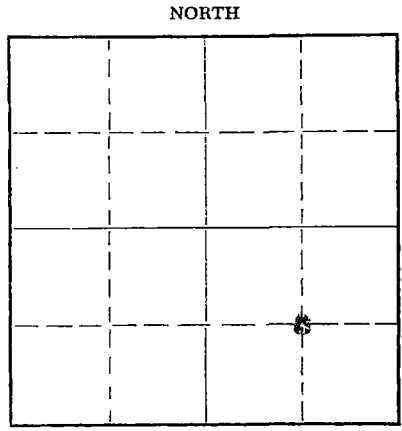

Locate well correctly on above Section Plat

If a producing well is abandoned, date of last production 19

Was permission obtained from the Conservation Division or its agents before plugging was commenced? yes

Name of Conservation Agent who supervised plugging of this well Mr. Frank Broadfoot

Producing formation _____ Depth to top _____ Bottom _____ Total Depth of Well _____ Feet
Show depth and thickness of all water, oil and gas formations.

OIL, GAS OR WATER RECORDS

CASING RECORD

FORMATION	CONTENT	FROM	TO	SIZE	PUT IN	PULLED OUT
(See Well Log Attached)				8 5/8"	1470'	-0-

Describe in detail the manner in which the well was plugged, indicating where the mud fluid was placed and the method or methods used in introducing it into the hole. If cement or other plugs were used, state the character of same and depth placed, from _____ feet to _____ feet for each plug set.

Plug - 20 Sacks bottom of hole - 5460'
20 Sacks bottom of 8 5/8" @ 1470'
10 Sacks top of hole

RECEIVED 12-8-1960
STATE CORPORATION COMMISSION
DEC 8 1960
CONSERVATION DIVISION
Wichita, Kansas

(If additional description is necessary, use BACK of this sheet)

Name of Plugging Contractor Holm Drilling Company
Address Tulsa, Oklahoma

STATE OF Texas, COUNTY OF Hutchinson, ss.
A. L. Robinson (employee of owner) or (owner or operator) of the above-described well, being first duly sworn on oath, says: That I have knowledge of the facts, statements, and matters herein contained and the log of the above-described well as filed and that the same are true and correct. So help me God.

(Signature) A. L. Robinson
Box 430 - Borger, Texas
(Address)

SUBSCRIBED AND SWORN TO before me this 7th day of December, 19 60

My commission expires 6/1/61

Jean Hardy
Notary Public.



Well Log
Hoopingarner #1

Location: Sec. 22-30S-43W, Stanton, County, Kansas
 Operator: Robinson Bros. Oil Producers
 Contractor: Holm Drilling Company
 Commenced: 10-27-60
 Spud: 10-27-60
 Rotary Work Completed : 11-15-60
 Rotary Depth: 5460'
 Casing Record: 8 5/8 @ 1470'

<u>Formation</u>	<u>Depth</u>
Surface Sand & Shale	0-135'
Shale, Sand & Clay	135' - 529'
Red Beds & Shale	529' - 660'
Gyp Anhydrite	660' - 710'
Sand & Shale	710' - 1060'
Red Beds & Gyp	1060' - 1218'
Sand - Lost Circ.	1218' - 1278'
No Samples - Dry Drilled	1278' - 1470'
Anhydrite	1470' - 1475'
Shale & Shells	1475' - 2060'
Shale & Gyp, Shells-Sand	2060' - 2335'
Shale & Shells	2335' - 2420'
Shale & Lime	2420' - 2775'
Lime & Shale	2775' - 5252'
Shale & Lime	5252' - 5335'
Shale & Sandy Lime	5335' - 5425'
Shale & Lime	5425' - 5460'

D&A

Plug = 20 Sacks bottom of hole
 20 Sacks bottom of 8 5/8" @ 1470'

Certified Copy of Well Log

HOLM DRILLING COMPANY

F. M. Rush

F. M. Rush

RECEIVED
STATE CORPORATION COMMISSION

DEC 8 1960

CONSERVATION DIVISION
Wichita, Kansas