


WELL PLUGGING RECORD

Give All Information Completely
Make Required Affidavits
Mail or Deliver Report to:
Conservation Division
State Corporation Commission
211 No. Broadway
Wichita, Kansas

NORTH

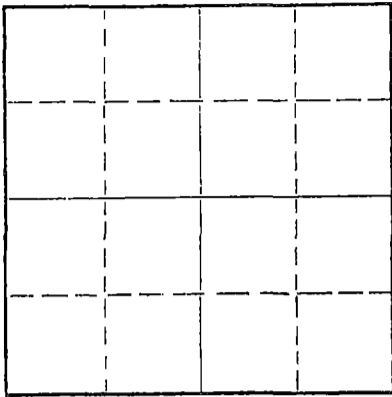

Locate well correctly on above
Section Plat

Mc Pherson County, Sec. 27 Twp. 20s Rge. 3w (E) (W)

Location as "NE/CNW%SW%" or footage from lines NE/4 NE/4 NW/4

Lease Owner Alfred Koehn

Lease Name Goering Well No. I

Office Address Galva, Kansas

Character of Well (completed as Oil, Gas or Dry Hole) oil

Date well completed Feb 3, 1964

Application for plugging filed Jan 1964

Application for plugging approved Jan 1964

Plugging commenced Jan 29, 1964

Plugging completed Feb 6, 1964

Reason for abandonment of well or producing formation Dry

If a producing well is abandoned, date of last production 19

Was permission obtained from the Conservation Division or its agents before plugging was commenced? Yes

Name of Conservation Agent who supervised plugging of this well Cecil Jones

Producing formation Depth to top Bottom Total Depth of Well 3130' Feet

Show depth and thickness of all water, oil and gas formations.

OIL, GAS OR WATER RECORDS

CASING RECORD

FORMATION	CONTENT	FROM	TO	SIZE	PUT IN	PULLED OUT
				6"		2460'

Describe in detail the manner in which the well was plugged, indicating where the mud fluid was placed and the method or methods used in introducing it into the hole. If cement or other plugs were used, state the character of same and depth placed, from feet to feet for each plug set.

Plugged off bottom of hole with rock. Rock from 3130' to 3095'. Dumped 5 sx of cement. Mudded hole to 175'. Made 10' of rock bridge. Dumped 20 sx of cement. Mudded hole to 29'. Made 5' of rock bridge. Dumped 8 sx of cement, filling to the bottom of the celler.

RECEIVED
STATE CORPORATION COMMISSION

FEB 12 1964

2-12-1964
CONSERVATION DIVISION
Wichita, Kansas

(If additional description is necessary, use BACK of this sheet)

Name of Plugging Contractor Art Lamb Casing Pulling Co.

Address P.O. Box 983 Hutchinson, Kansas

STATE OF Kansas, COUNTY OF Reno, ss.

Art Lamb (employee of owner) or (owner or operator) of the above-described well, being first duly sworn on oath, says: That I have knowledge of the facts, statements, and matters herein contained and the log of the above-described well as filed and that the same are true and correct. So help me God.

(Signature) Art Lamb

2809 Kings Dr., Hutchinson, Kansas
(Address)

SUBSCRIBED AND SWORN to before me this 11 th day of February, 1964

My commission expires January 5, 1966

Judy Lamb
Notary Public.



RECEIVED
STATE CORPORATION COMMISSION
15.113.00246.00.00

FEB 12 1964

W E L L R E C O R D

CONSERVATION DIVISION
Wichita, Kansas

LEASE: Goering WELL NO. 1

LOCATION: NE/4 NE/4 NW/4 DATE COMMENCED: January 28, 1959
Section 27-20S-3W
McPherson County DATE COMPLETED: February 3, 1959
Kansas (rotary)

OPERATOR: Alfred Koehn
Galva, Kansas

CONTRACTOR: J. A. Melland, Rotary Drilling Contractor
1111 North Main Street
Hutchinson, Kansas

CASING RECORD: 8-5/8" OD casing set at 165' with 110 sacks of cement with
1% calcium chloride. Cement circulated.
6" OD casing set at 3106' with 50 sacks of cement.

<u>FORMATION</u>	<u>LOG</u>	<u>REMARKS</u>
Surface soil, clay & sand	165	8-5/8" casing set at 165'
Shale & shells	380	
Shale & gypsum	410	
Gypsum	475	
Gypsum, lime & shale	570	
Shale & lime	675	
Lime & shale	975	
Shale & lime	1100	
Shale & shells	1470	
Lime & shale	1615	
Shale & lime	1730	
Lime & shale	2190	
Shale & sandy lime	2300	
Shale & lime	2420	
Lime & shale	2936	
Shale & lime	3080	
Mississippi Lime	3130	6" OD casing at 3106'
ROTARY TOTAL DEPTH	3130	

RECEIVED
STATE CORPORATION COMMISSION

FEB 12 1964

CONSERVATION DIVISION
Wichita, Kansas

