


STATE OF KANSAS
STATE CORPORATION COMMISSION

WELL PLUGGING RECORD

Give All Information Completely
Make Required Affidavit
Mail or Deliver Report to
Conservation Division
State Corporation Comm.
245 North Water
Wichita, KS 67202

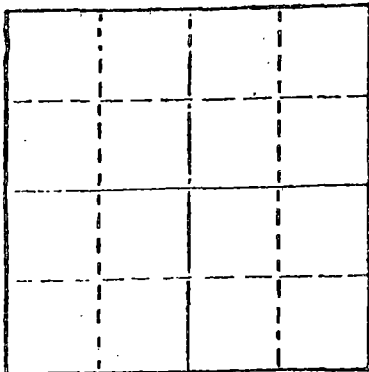

Locate well correctly on above
Section Plot

McPherson County. Sec. 27 Twp. 20 Rge. 3W E/W
Location as "NE/CNW $\frac{1}{4}$ SW $\frac{1}{4}$ " or footage from lines
330' WEL. & 150' S. of SE NW NW Section 27-20-3W.
Lease Owner Thomas Schrag
Lease Name Stucky C Well No. 1
Office Address R#2, Burrton, Kansas 67020
Character of Well (Completed as Oil, Gas or Dry Hole) Dry
Date Well completed September 22, 1980
Application for plugging filed 19
Application for plugging approved 19
Plugging commenced 19
Plugging completed September 22, 1980
Reason for abandonment of well or producing formation Dry

If a producing well is abandoned, date of last production 19

Was permission obtained from the Conservation Division or its agents before plugging was commenced? Yes

Name of Conservation Agent who supervised plugging of this well Gilbert Toman, Holyrood, Ks.
Producing formation Depth to top Bottom Total Depth of Well
Show depth and thickness of all water, oil and gas formations.

OIL, GAS OR WATER RECORDS

CASING RECORD

FORMATION	CONTENT	FROM	TO	SIZE	PUT IN	PULLED OUT
Clay & Shale		0	95'	8 5/8"	95'	None
Shale		95'	126'	8 5/8"	31	None

Describe in detail the manner in which the well was plugged, indicating where the mud fluid was placed and the method or methods used in introducing it into the hold. If cement or other plugs were used, state the character of same and depth placed, from feet to feet for each plug set.

Set bottom plug at 125' with 20 sacks of cement. Top plug at 40' with 10 sacks of cement, 2 sacks in rathole. Plugging completed at 4:00 A. M., September 22, 1980.
State Plugger, Gilbert Toman, Holyrood, Kansas.

10-15-1980
RECEIVED

STATE CORPORATION COMMISSION

OCT 15 1980

(If additional description is necessary, use BACK of this sheet)


Name of Plugging Contractor Blackstone Drilling, Inc., P.O. Box 1184, McPherson, KS 6746
Wichita, Kansas

STATE OF Kansas COUNTY OF McPherson, ss.
Thomas Schrag (employee of owner) or (owner or operator)
of the above-described well, being first duly sworn on oath, says: That I have knowledge of the facts, statements, and matters herein contained and the log of the above-described well as filed and that the same are true and correct. So help me God.

(Signature)


Thomas Schrag
R#2, Burrton, Kansas 67020
(Address)

SUBSCRIBED AND SWORN TO before me this 12th day of Oct, 19 80

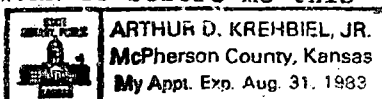

Arthur D. Krehbiel, Jr.
Notary Public.

My commission expires

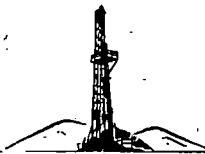

15.113.20768.00.00

Blackstone Drilling, Inc.

Box 1184 • 523 West Kansas • Phone (316) 241-1250

McPHERSON, KANSAS 67460

September 22, 1980

COMPANY: THOMAS SECURAC
CONTRACTOR: BLACKSTONE DRILLING, INC.
FARM: STUCKY C#1
LOCATION: 330' WEL & 150' S of SE NW NW 27-20-3W,
McPherson County, Kansas
COMMENCED: September 16, 1980
COMPLETED: September 22, 1980
ELEVATION:

0	to	95	Clay & Shale
95	to	135	Shale
135	to	690	Shale & Lime
690	to	1090	Lime & Shale
1090	to	1945	Shale & Lime
1945	to	2080	Lime & Shale
2080	to	2435	Shale & Lime
2435	to	2870	Lime & Shale
2870	to	3100	Shale & Lime
3100	to	3126	Lime
		3126	T. D.

Cut 12 $\frac{1}{4}$ " hole to 126' and run 128' of 8 5/8" surface casing, cemented with 100 sacks of cement at 126'. Plug down at 12:30 P. M., September 16, 1980. Hole dry & abandoned. Set bottom plug at 125' with 20 sacks of cement. Top plug at 40' with 10 sacks of cement, 2 sacks in rathole. Plugging completed at 4:00 A. M., September 22, 1980. Gilbert Toman, State Plugger, Holyrood, Kansas.

TOPS:

Measurements taken from K. B.


CERTIFICATE

I, P. E. Plouffe, President of Blackstone Drilling, Inc. do hereby certify that the above and foregoing is a true and correct copy of log on your Stucky C#1, located on the 330' WEL & 150' S. of SE NW NW Section 27-20-3W, McPherson County, Kansas as reflected by the files of Blackstone Drilling, Inc.


P. E. Plouffe, President

Subscribed and sworn to before me a Notary Public in and for McPherson County, Kansas this 23rd day of September, 1980.


Johnnie L. Schmidt - Notary Public

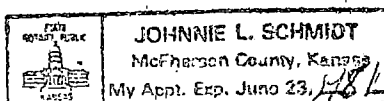RECEIVED
STATE CORPORATION COMMISSION

OCT 15 1980

CONSERVATION DIVISION
Wichita, Kansas