


STATE OF KANSAS  
STATE CORPORATION COMMISSION

WELL PLUGGING RECORD

Give All Information Completely  
Make Required Affidavit  
Mail or Deliver Report to  
Conservation Division  
State Corporation Comm.  
245 North Water  
Wichita, KS 67202

Kiowa County, Sec. 6 Twp. 30S Rge. 17 E/W  
Location as "NE/CNW $\frac{1}{4}$ SW $\frac{1}{4}$ " or footage from lines  
C SE SE

Lease Owner Exito Oil Company, Inc.  
Lease Name Kane Well No. 1  
Office Address 5310 East 31st. - Tulsa, Oklahoma 74135  
Character of Well (Completed as Oil, Gas or Dry Hole)  
Dry Hole

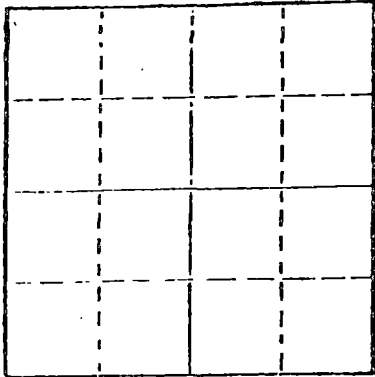

Locate well correctly on above  
Section Plat

Date Well completed December 12, 1977  
Application for plugging filed December 12, 1977  
Application for plugging approved December 12, 1977  
Plugging commenced December 12, 1977  
Plugging completed December 12, 1977  
Reason for abandonment of well or producing formation  
dry hole

If a producing well is abandoned, date of last production  
19

Was permission obtained from the Conservation Division or  
its agents before plugging was commenced? yes

Name of Conservation Agent who supervised plugging of this well Bill Owen  
Producing formation Depth to top Bottom Total Depth of Well 3400  
Show depth and thickness of all water, oil and gas formations.

OIL, GAS OR WATER RECORDS

CASING RECORD

FORMATION	CONTENT	FROM	TO	SIZE	PUT IN	PULLED OUT
	Surface					
	Casing	0	244'	8 5/8"	244'	none

Describe in detail the manner in which the well was plugged, indicating where the mud fluid was placed and the method or methods used in introducing it into the hold. If cement or other plugs were used, state the character of same and depth placed, from feet to feet for each plug set.

Plug at 255' with 40 sacks cement,  
plug at 40' with 35 sacks cement  
to bottom of cellar, 3 sacks of  
cement in rat hole. Job completed  
at 1:00 A.M. - 12-12-77. Cement by  
Sun Cementing Company

RECEIVED  
STATE CORPORATION COMMISSION

DEC 13 1977

CONSERVATION DIVISION  
Wichita, Kansas 12-13-1977

(If additional description is necessary, use BACK of this sheet)

Name of Plugging Contractor Search Drilling Company

STATE OF Kansas COUNTY OF Sedgwick, ss.  
R. M. Stagl (employee of owner) or (owner or operator)  
of the above-described well, being first duly sworn on oath, says: That I have knowledge of the facts, statements, and matters herein contained and the log of the above-described well as filed and that the same are true and correct. So help me God.

(Signature) R. M. Stagl  
Wichita, Kansas

(Address)

SUBSCRIBED AND SWORN TO before me this 12th day of December, 1977

Maxine Dressen  
Maxine Dressen Notary Public.

My commission expires February 22, 1981



DRILLERS LOG

15-097-20428-0000

KANE #1

CASING RECORD:  
8 5/8" set at 244'  
with 250 sacks cement

OPERATOR: Exito Oil Company, Inc.  
CONTRACTOR: Search Drilling Company

DESCRIPTION:  
C SE SE  
Section 6-30S-17W  
Kiowa County,  
Kansas

TOTAL DEPTH:  
3400'

COMMENCED: December 6, 1977  
COMPLETED: December 12, 1977

<u>FORMATION</u>	<u>FROM</u>	<u>TO</u>	<u>REMARKS</u>
Native Clay	0	125	
Clay	125	250	
Red Bed	250	270	
Lime and Shale	270	555	
Lime and Shale	555	2280	
Lime and Shale	2280	2566	
Lime and Shale	2566	3091	
Lime and Shale	3091	3360	
Lime and Shale	3360	3400	
Rotary Total Depth	3400		D & A

RECEIVED  
STATE CORPORATION COMMISSION  
DEC 13 1977  
CONSERVATION DIVISION  
Wichita, Kansas

I certify that this is a true and correct copy of the above log to the best of knowledge.

SEARCH DRILLING COMPANY

R. M. Stagi  
R. M. Stagi

Subscribed and sworn to before me this 12th day of December, 1977.

My appointment expires:  
February 22, 1981

Maxine Dressen  
Maxine Dressen Notary Public

