


STATE OF KANSAS
STATE CORPORATION COMMISSION

Form CP-4

WELL PLUGGING RECORD

Give All Information Completely
Make Required Affidavit
Mail or Deliver Report to:
Conservation Division
State Corporation Commission
212 No. Market
Wichita, Kansas

NORTH

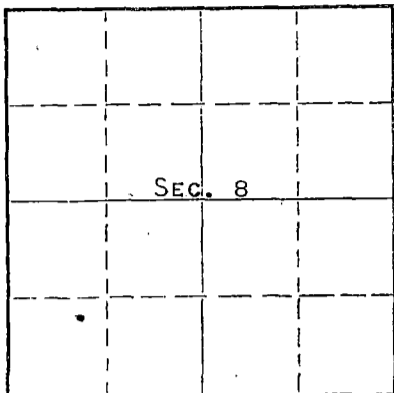

Locate well correctly on above
Section Plat

KIOWA County. Sec. 8 Twp. 30S Rge. 17 (E) (W)
Location as "NE/CNW&SW&" or footage from lines. APP. C SW
Lease Owner PETROLEUM, INC.
Lease Name KANE UNIT Well No. 1
Office Address R.R. #2, GREAT BEND, KANSAS
Character of Well (completed as Oil, Gas or Dry Hole) DRY HOLE
Date well completed MARCH 17 19 67
Application for plugging filed MARCH 17 19 67
Application for plugging approved MARCH 17 19 67
Plugging commenced MARCH 17 19 67
Plugging completed MARCH 17 19 67
Reason for abandonment of well or producing formation NO PRODUCIBLE ZONE

If a producing well is abandoned, date of last production NONE 19
Was permission obtained from the Conservation Division or its agents before plugging was commenced? YES

Name of Conservation Agent who supervised plugging of this well ARCHIE ELVING
Producing formation _____ Depth to top _____ Bottom _____ Total Depth of Well 4845' Feet
Show depth and thickness of all water, oil and gas formations.

OIL, GAS OR WATER RECORDS

CASING RECORD

FORMATION	CONTENT	FROM	TO	SIZE	PUT IN	PULLED OUT
				8-5/8"	505'	NONE

Describe in detail the manner in which the well was plugged, indicating where the mud fluid was placed and the method or methods used in introducing it into the hole. If cement or other plugs were used, state the character of same and depth placed, from _____ feet to _____ feet for each plug set.

MUD TO 400', FOLLOWED BY WOODEN PLUG, PLACED 2 SACKS DRY CEMENT, 1/2 SACK HULLS, 23 SACKS CEMENT ON TOP OF PLUG. MUD TO 40' FOLLOWED BY WOODEN PLUG, 1 SACK DRY CEMENT, 1/2 SACK HULLS, 9 SACKS CEMENT ON TOP OF PLUG TO BASE OF WELL CELLAR.

RECEIVED
MAR 20 1967
3-29-67
CONSERVATION DIVISION
WICHITA, KANSAS

(If additional description is necessary, use BACK of this sheet)

Name of Plugging Contractor GARVEY DRILLING COMPANY
Address R.R. #2, GREAT BEND, KANSAS

STATE OF KANSAS, COUNTY OF BARTON, ss.
MONTE CHADD (employee of owner) or (owner or operator) of the above-described well, being first duly sworn on oath, says: That I have knowledge of the facts, statements, and matters herein contained, and the log of the above-described well as filed and that the same are true and correct. So help me God. MONTE CHADD, DIST. PROD. SUPT.

(Signature) Monte Chadd
R.R. #2, GREAT BEND, KANSAS
(Address)

SUBSCRIBED AND SWORN TO before me this 28 day of MARCH, 19 67

My commission expires MAY 28, 1969

Richard A. D...
Notary Public.

WELL LOG

COMPANY Petroleum, Inc.

SEC. 8 T. 30S R. 17W

FARM Kane Unit

NO. 1

LOC. App SW


TOTAL DEPTH 4845'

COUNTY Kiowa

COMM. 3-3-67

COMP. 3-17-67

CONTRACTOR Garvey Drilling Company

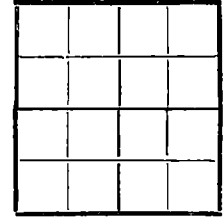

CASING 8 5/8" @ 505' w/450 sx

ELEVATION 1956' DF

PRODUCTION D & A

FIGURES INDICATE BOTTOM OF FORMATIONS

- 80' Sand Rock
- 875' Red Bed, Gyp and Rock
- 905' Anhydrite
- 1053' Red Bed
- 1150' Red Bed and Shale
- 1900' Shale and Shells
- 2270' Lime and Shale
- 2320' Lime
- 2370' Lime and Shale
- 2440' Lime
- 3175' Lime and Shale
- 3500' Shale and Lime
- 3900' Lime and Shale
- 3972' Lime
- 4190' Shale and Lime
- 4300' Lime
- 4327' Lime and Chert
- 4400' Lime
- 4440' Lime and Shale
- 4450' Lime
- 4575' Lime and Shale
- 4605' Lime
- 4670' Lime and Shale
- 4725' Lime
- 4775' Shale and Lime
- 4800' Lime and Shale
- 4815' Lime, Shale and Chert
- 4845' Lime
- 4845' RTD

RECEIVED
STATE CORPORATION COMMISSION

MAR 29 1967

CONSERVATION DIVISION
Wichita, Kansas

State of Kansas }
County of Barton } SS

I, Sam N. Stephens of Garvey Drilling Company

upon oath state the above and foregoing is a true and correct copy of the log of the Kane Unit No. 1 well.

Sam N. Stephens

Subscribed and sworn to before me this 22nd day of March 19 67

My Commission Expires: November 5th, 1969

Richard D. Doy
NOTARY PUBLIC