


STATE OF KANSAS
STATE CORPORATION COMMISSION

API # - none

WELL PLUGGING RECORD

Give All Information Completely
Make Required Affidavit
Mail or Deliver Report to
Conservation Division
State Corporation Comm.
245 North Water
Wichita, KS 67202

Kiowa County. Sec. 25 Twp. 30S Rge. 17 W
Location as "NE/CNW 1/4 SW 1/4" or footage from lines
1301' FNL & 1320' FEL of Section 25.
Lease Owner Gulf Oil Corporation
Lease Name E.D. Robbins "I" Well No. 1
Office Address P.O. Box 12116, Oklahoma City, OK 73157
Character of Well (Completed as Oil, Gas or Dry Hole) Gas

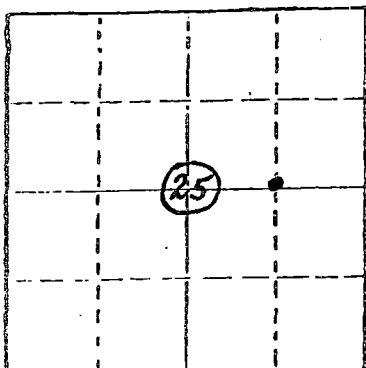

Locate well correctly on above
Section Plat

Date Well completed December 24, 19 57
Application for plugging filed February 1, 19 83
Application for plugging approved February 21, 19 83
Plugging commenced May 17, 19 83
Plugging completed May 19, 19 83
Reason for abandonment of well or producing formation
Uneconomical to operate

If a producing well is abandoned, date of last production
September 1st 19 79

Was permission obtained from the Conservation Division or
its agents before plugging was commenced? YES

Name of Conservation Agent who supervised plugging of this well Robert Tarbutton
Producing formation Mississippi Depth to top 4949 Bottom 4980 Total Depth of Well 5070
Show depth and thickness of all water, oil and gas formations.

OIL, GAS OR WATER RECORDS

CASING RECORD

FORMATION	CONTENT	FROM	TO	SIZE	PUT IN	PULLED OUT
Mississippi	Gas	4949	4980	8-5/8"	402	-0-
				4-1/2"	4980	2868

Describe in detail the manner in which the well was plugged, indicating where the mud fluid
was placed and the method or methods used in introducing it into the hold. If cement or other
plugs were used, state the character of same and depth placed, from _____ feet to
_____ feet for each plug set.

MIRU Clarke, POH w/rods & tbg. RIH w/2-3/8" tbg to 4859' FL. MIRU Howco, circ well full
w/70 bbl 9 ppg mud. Spot 25 sx Class "A" cmt f/4859-4537' KB. POH w/tbg. Cut csg @ 2868'.
POH w/4-1/2" csg to 424'. MI Howco, circ 200 sx Class "A" cmt dn 4-1/2" to surface. POH
with csg. Topped off csg. Cut csg 5' BGL. Weld on cap and ID well. Restore surface.
Well was P&A 05/19/83.

(If additional description is necessary, use BACK of this sheet)

Name of Plugging Contractor Clarke Corporation - KCC LIC #5105

STATE OF OKLAHOMA COUNTY OF OKLAHOMA, ss.
Dorretta Moore (employee of ~~XXXXXXXXXXXXXXXXXXXX~~ operator)
of the above-described well, being first duly sworn on oath, says: That I have knowledge of
the facts, statements, and matters herein contained and the log of the above-described well
as filed and that the same are true and correct. So help me God.

(Signature) Dorretta Moore
c/o Gulf Oil at address listed above.
(Address)

SUBSCRIBED AND SWORN TO before me this 27th day of JULY 19 83.

Steve R. Walker
Notary Public.

My commission expires 09-15-85

7-28-1983
RECEIVED
STATE CORPORATION COMMISSION

JUL 28 1983

15-097-10069-0001

E. D. ROBBINS I #1

Well Record

Location: Section 25-308-17W
Kiowa County, Kansas

Commenced: November 28, 1957
Completed: December 24, 1957
(rotary)

Operator: Gulf Oil Corporation
Union Center Building
Wichita, Kansas

Contractor: Graham-Michaelis Drilling Co.
211 North Broadway
Wichita, Kansas

Casing Record: 8 5/8" @402' W/325 sacks Pozmix Cement
4 1/2" @4980' W/150 sacks Pozmix Cement

	<u>LOG</u>
Shale-Gyp & Clay	260
Shale-Shells	2202
Lime & Shale	2295
Lime	2350
Shale & Lime	2450
Lime & Shale	2505
Lime	2825
Lime & Shale	3081
Lime Streaks & Shale	3300
Shale & Lime	3384
Lime & Shale	3742
Lime	3831
Lime Shale	4060
Lime	4107
Lime Shale	4230
Lime	4324
Lime & Shale	4375
Lime	4441
Lime & Shale	4480
Lime	4540
Lime & Shale	4571
Lime	4681
Lime & Shale	4765
Lime	4803
Lime & Shale	4835
Cherty Lime	4876
Chert Lime & Shale	4917
Lime-Chert	4930
Miss.	4949
Chert-Lime & Shale	4980
Lime	5042
Chert Lime & Shale	5070, RFD.

STATE OF KANSAS)
) ss.
COUNTY OF SEDGWICK)

The undersigned, GRAHAM-MICHAELIS DRILLING COMPANY, hereby certifies that the above log is a true and correct log of the formation encountered in drilling the above well as reflected by the Daily Drilling Report.

GRAHAM-MICHAELIS DRILLING COMPANY

By: John L. James
John L. James, Geologist.

Subscribed and sworn to before me
this 2nd day of January, 1958.

P. J. [Signature]
My commission expires: 1/7/61.

FEB 4 1958

Wichita, Kansas

copy to KGS 2-6-58