


STATE OF KANSAS
STATE CORPORATION COMMISSION

Form CP-4

Give All Information Completely
Make Required Affidavit
Mail or Deliver Report to:
Conservation Division
State Corporation Commission
P. O. Box 17027

WELL PLUGGING RECORD

Wichita, Kansas 67217
NORTH

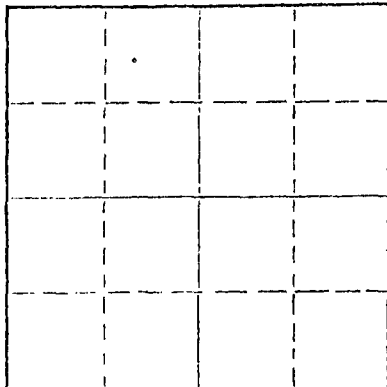

Locate well correctly on above
Section Plat

Kiowa County, Sec. 29 Twp. 30S Rge. 17W (E) (W)
Location as "NE/CNW/SW" or footage from lines 1260' FNL & 1050' FEL (corrected
Lease Owner G. T. McAlpin 1370' FNL - 1040' FGL location)
Lease Name Booth J2-KCC Well No. 1
Office Address 5711 Happy Canyon Dr., Englewood, Colorado
Character of Well (completed as Oil, Gas or Dry Hole) D & A
Date well completed January 27 19 74
Application for plugging filed January 27 19 74
Application for plugging approved January 27 19 74
Plugging commenced January 27 19 74
Plugging completed January 27 19 74
Reason for abandonment of well or producing formation D & A

If a producing well is abandoned, date of last production 19
Was permission obtained from the Conservation Division or its agents before plugging was com-
menced? Yes

Name of Conservation Agent who supervised plugging of this well G. R. Biberstein
Producing formation Depth to top Bottom Total Depth of Well 5035 Feet
Show depth and thickness of all water, oil and gas formations.

OIL, GAS OR WATER RECORDS

CASING RECORD

FORMATION	CONTENT	FROM	TO	SIZE	PUT IN	PULLED OUT
				8 5/8"	415'	-0-

Describe in detail the manner in which the well was plugged, indicating where the mud fluid was placed and the method or methods used in introducing it into the hole. If cement or other plugs were used, state the character of same and depth placed, from feet to feet for each plug set.

Plug @ 350' w/40 sx & 15 sx
@ 40'. Rathole plugged.

This well was taken over by Anadarko Production Company and was thereby plugged in accordance with state regulations by Anadarko.

RECEIVED 1-30-1974
STATE CORPORATION COMMISSION
JAN 30 1974
CONSERVATION DIVISION
Wichita, Kansas

(If additional description is necessary, use BACK of this sheet)
Name of Plugging Contractor B & B Drilling, Inc.
Address 720 Union Center, Wichita, Kansas

STATE OF KANSAS COUNTY OF SEDGWICK
Bill Lahar (employee of owner) or (owner or operator) of the above-described

well, being first duly sworn on oath, says: That I have knowledge of the facts, statements, and matters herein contained and the log of the above-described well as filed and that the same are true and correct. So help me God.

(Signature) Bill Lahar
720 Union Center, Wichita, Kansas
(Address)

SUBSCRIBED AND SWORN to before me this 29th day of January, 19 74

commission expires January 29, 1977
Betty M. Maloney Notary Public.

January 28, 1974

DRILLERS LOG

#1 Booth
 1260' FNL & 1050' FEL (corrected loc.)
 of Sec. 29-30S-17W
 Kiowa County, Kansas
 1370' FNL-
 1040' FEL
 JR-KCC

OPERATOR: G. T. McAlpin
 CONTRACTOR: B & B Drilling, Inc.
 COMMENCED: January 15, 1974
 COMPLETED: January 27, 1974

8 5/8" @ 415' w/250 sx

0	130	Surface clay & sand	
130	310	Shale	
310	365	Sand	
365	417	Shale	
417	1064	Shale & Red Bed	
1064	1086	Anhydrite	
1086	1095	Shale	
1095	1610	Shale	
1610	1990	Shale & Shells	
1990	4195	Shale & Lime	
4195	5035	Lime	
5035		RTD	D & A

RECEIVED
 STATE CORPORATION COMMISSION
 JAN 30 1974
 CONSERVATION DIVISION
 Wichita, Kansas

We certify that the above and foregoing is a true and correct copy of the log on the #1 Booth, located in Kiowa County, Kansas.

B & B DRILLING, INC.

Bill Lahar
 Bill Lahar

Subscribed and sworn to before me this 29th day of January, 1974.

Betty M. Maloney
 Betty M. Maloney Notary Public

My Commission Expires:

January 29, 1977